

MISSISSIPPI DEPARTMENT OF NATURAL RESOURCES

Bureau of Land and Water Resources

Southport Mall

P.O. Box 10631

Jackson, Mississippi 39209

WATER WELL DRILLERS LOG

TATE  
N  
202A

6/13 19 84 date well completed      WOODS WELL CO. firm name:      Tate county well located

LANDOWNER: Albert Watson      description of formations encountered      from      to

pt. 1

Senatobia, Mo. 38668      Red clay      0      10  
(mailing address)

3 miles S of Loxahom      Red sand      10      50  
(distance) (direction) (nearest town)

WELL LOCATION:      White sande clay      50      110  
sec. 14 T. 6 N. R. 6 E  
3 miles S of Loxahom      White sand      110      155  
(distance) (direction) (nearest town)

WELL PURPOSE: Home  
(home, irrigation, municipal, industrial)

WELL COMPLETION DATA:

(1) diameter (inches) 4

(2) total depth (feet) 155

(3) static water level (feet) 80 below above top of ground.

(4) casing PVC 155'  
(material) (depth)  
4"  
(size) if telescope see back.

(5) screen 10' 145'  
(length) (depth to top)  
0.10 PVC  
(size) (material)

(6) pump 1/2 10  
(HP) (yield gpm)  
220V  
(type power)

(7) electric log No  
(yes or no)  
(organization running log)


(8) how well bottom plugged Cap

DRILLERS REMARKS:

DEPT. OF NATURAL RESOURCES  
BUREAU OF LAND & WATER RESOURCES  
JUL 10 1984  
RECEIVED

If well telescopes please sketch and show depths.

GROUND LEVEL

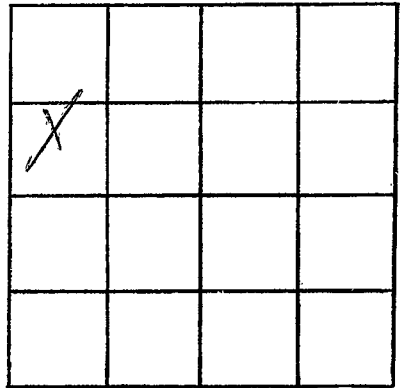

SECTION 14

Please indicate well location X.

ADDITIONAL INFORMATION

Lined area for additional information.

If more than one screen, show locations of each on sketch.