

MISSISSIPPI DEPARTMENT OF NATURAL RESOURCES

Bureau of Land and Water Resources

Southport Mall

P.O. Box 10631

Jackson, Mississippi 39209

WATER WELL DRILLERS LOG

Date
 N
 2030

9-12-1984
 date well completed

NICKS WELL CO
 Firm name
 Rt 1, Box 157

Tate
 county well located

LANDOWNER: Jim McNeal
 Rt 1
 Senatobia, Ms. 38668
 (mailing address)

description of formations encountered	from	to
Red Clay	0	20
Red Sand + Clay	20	60
White Sand + Clay	60	150
White Sand	150	173

WELL LOCATION:
 sec 14 T 6 N R 6 E
 3 miles SE of Poplarville
 (distance) (direction) (nearest town)

WELL PURPOSE: Home
 (home, irrigation, municipal, industrial)

WELL COMPLETION DATA:

(1) diameter (inches) 4

(2) total depth (feet) 173

(3) static water level (feet) 120 below top of ground.

(4) casing PVC, 173 (material), (depth)
 4" if telescope see back. (size)

(5) screen 10' 163 (length), (depth to top)
 .010 PVC (size), (material)

(6) pump 1/2 10 (HP), (yield gpm)
 2200 (type power)

(7) electric log No (yes or no)

(organization running log)

(8) how well bottom plugged Csp

DRILLERS REMARKS:


DEPT. OF NATURAL RESOURCES
 BUREAU OF LAND & WATER RESOURCES

SEP 24 1984

RECEIVED

If well telescopes please sketch and show depths.

GROUND LEVEL

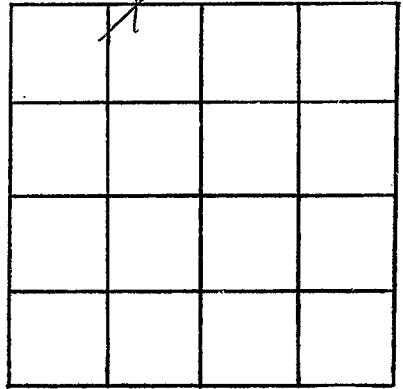

SECTION

14

Please indicate well location X.

ADDITIONAL INFORMATION

If more than one screen,
show locations of each on sketch.