

MISSISSIPPI DEPARTMENT OF NATURAL RESOURCES

Bureau of Land and Water Resources

Southport Mall

P.O. Box 10631

Jackson, Mississippi 39209

WATER WELL DRILLERS LOG

HICKS WELL CO.

P.O. Box 157

firm name  
Spartanburg, MS 38668

county well located

Date  
N  
2031

7-11-1984  
date well completed

Tate


LANDOWNER: <u>Jerry Levenson</u> <u>Bt. 1</u>	description of formations encountered	from	to
<u>Senatobia No. 38668</u> (mailing address)	<u>Red Clay</u>	0	15
WELL LOCATION: sec. <u>16</u> T. <u>6</u> N. R. <u>6</u> E <u>3</u> miles <u>S</u> of <u>Senatobia</u> (distance) (direction) (nearest town)	<u>Red Sand</u>	15	50
WELL PURPOSE: <u>Home</u> (home, irrigation, municipal, industrial)	<u>White Sand</u>	50	140
WELL COMPLETION DATA: (1) diameter (inches) <u>4</u> (2) total depth (feet) <u>140</u> (3) static water level (feet) <u>80</u> <sup>below</sup> <del>above</del> top of ground. (4) casing <u>PVC</u> , <u>140</u> , (material) (depth) <u>4"</u> (size) if telescope see back. (5) screen <u>10'</u> , <u>130'</u> (length) (depth to top) <u>.010</u> <u>PVC</u> (size) (material) (6) pump <u>1/2</u> <u>10</u> (HP) (yield gpm) <u>220V</u> (type power) (7) electric log <u>No</u> (yes or no) (organization running log) (8) how well bottom plugged <u>Cap</u>			
DRILLERS REMARKS:			

DEPT. OF NATURAL RESOURCES  
BUREAU OF LAND & WATER RESOURCES

SEP 24 1984  
RECEIVED

If well telescopes please sketch and show depths.

GROUND LEVEL

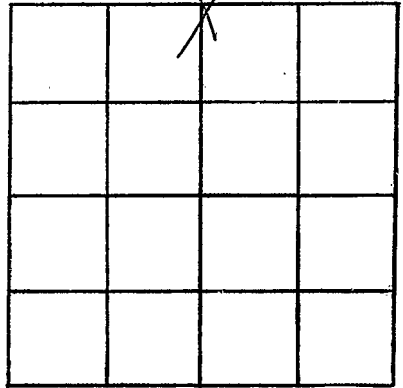

SECTION 16

Please indicate well location X.

ADDITIONAL INFORMATION

If more than one screen, show locations of each on sketch.