

MISSISSIPPI DEPARTMENT OF NATURAL RESOURCES

Bureau of Land and Water Resources

Southport Mall

P.O. Box 10631

Jackson, Mississippi 39209

WATER WELL DRILLERS LOG

HICKS WELL COMPANY

N 2032
Tate
7-9-85

date well completed 7-9 1985

RI. firm name 157
SENATOBIA, MISS

county well located Tate

LANDOWNER: Kevin Snider

description of formations encountered

from

to

Rt #1

Red Clay

0

20

Senatobia MS 38868
(mailing address)

Red Sand

20

50

WELL LOCATION:

sec. 14 T. 6 N. R. 6 E
5 miles SE of Loxahatchee
(distance) (direction) (nearest town)

White Clay

50

80

WELL PURPOSE: HOMP
(home, irrigation, municipal, industrial)

White Sand

80

156

WELL COMPLETION DATA:

- diameter (inches) 4"
- total depth (feet) 155'
- static water level (feet) 200 ^{below} above top of ground.
- casing PVC, 145'
(material) (depth)
4"
(size) if telescope see back.
- screen 10', 145'
(length) (depth to top)
.013, PVC
(size) (material)
- pump 1/2, 10
(HP) (yield gpm)
220 V
(type power)
- electric log NO
(yes or no)

(organization running log)

(8) how well bottom plugged Cap


RECEIVED
OCT 17 1985

DRILLERS REMARKS:

Department of Natural Resources
Bureau of Land & Water Resources

If well telescopes please sketch and show depths.

GROUND LEVEL

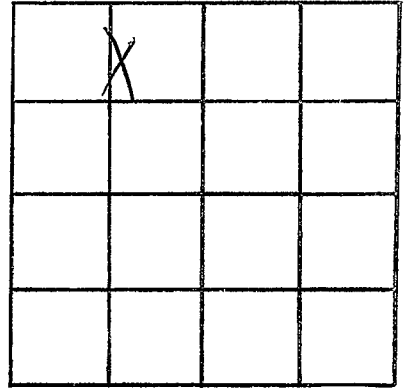

SECTION 14

Please indicate well location X.

ADDITIONAL INFORMATION

If more than one screen,
show locations of each on sketch.