

MISSISSIPPI DEPARTMENT OF NATURAL RESOURCES

Bureau of Land and Water Resources

Southport Mall

P.O. Box 10631


Jackson, Mississippi 39209

WATER WELL DRILLERS LOG

TARE
N
2033

3-17-1986 date well completed Wicks Well Co. firm name Date county well located


LANDOWNER:	description of formations encountered	from	to
Willie Porter Rt # 1 Senatobia, MS 38668 (mailing address)			
	Red sand	20	50
	White sand	50	140
WELL LOCATION:			
sec. 16 T. 6 N. R. 6 E S W			
4 miles S of Senatobia (distance) (direction) (nearest town)			
WELL PURPOSE: (home, irrigation, municipal, industrial) HOME			
WELL COMPLETION DATA:			
(1) diameter (inches) 4"			
(2) total depth (feet) 140'			
(3) static water level (feet) 80' below top of ground.			
(4) casing (material) PVC, (depth) 130'			
4" (size) if telescope see back.			
(5) screen (length) 10', (depth to top) 130'			
013 4" (size), PVC (material)			
(6) pump 1/2 (HP), 10 (yield gpm)			
220V (type power)			
(7) electric log NO (yes or no)			
(organization running log)			
(8) how well bottom plugged Cap			
DRILLERS REMARKS:			

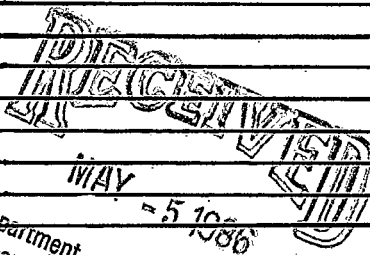

Department of Natural Resources
Bureau of Land & Water Resources

If well telescopes please sketch and show depths.

GROUND LEVEL

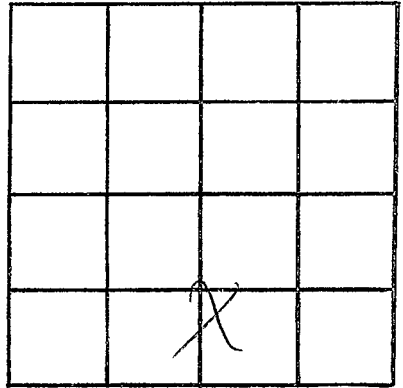

SECTION 16

Please indicate well location X.

ADDITIONAL INFORMATION

If more than one screen,
show locations of each on sketch.