

MISSISSIPPI DEPARTMENT OF NATURAL RESOURCES

Bureau of Land and Water Resources

P.O. Box 10631

Jackson, Mississippi 39209

WATER WELL DRILLERS LOG

COUNTY WELL LOCATED	
TATE	
WELL NUMBER	CODED
N	
DATE WELL COMPLETED	
8-2-89	

PERMIT NUMBER
HICKS WELL COMPANY
NAME OF DRILLING FIRM
RT. 1 - BOX 197
SENATOBIA, MISS.

NAME & MAILING ADDRESS OF LANDOWNER			
Joe Bradley			
RT. 3			
Senatobia, MS.			
WELL LOCATION:	SEC	TOWNSHIP	RANGE
	29	6 N	6 W
DISTANCE	DIRECTION	NEAREST TOWN	
5 Miles	East	of Senatobia	
OTHER LANDMARK			
WELL PURPOSE: <input checked="" type="checkbox"/> Home Irrigation, <input type="checkbox"/> Municipal, <input type="checkbox"/> Industrial, <input type="checkbox"/> Fish Pond, etc.			

PUMP DATA				
PUMP TYPE (Circle One):				
<input checked="" type="checkbox"/> Submersible	<input type="checkbox"/> Turbine	<input type="checkbox"/> Jet	<input type="checkbox"/> Flowing Well	
Other (Describe) _____				
POWER TYPE (Circle One):				
<input checked="" type="checkbox"/> Electric	<input type="checkbox"/> Tractor	<input type="checkbox"/> Diesel	<input type="checkbox"/> Gasoline	<input type="checkbox"/> Butane
Other (Describe) _____ H/P _____				
Pump Capacity (GPM)	No. of Stages	Setting Depth		
10	9	90 FT.		
PUMP TEST				
Well yielded _____ GPM with				
a drawdown of _____ ft.				
after _____ hours of pumping				

WELL DATA		
Well Depth	Casing Diameter (In.)	Casing Length (Ft.)
140	4"	130
Type of Casing	Hole Depth	Depth to Static Water Level
PVC	140	100
TYPE OF COMPLETION: (Circle One or More):		
<input checked="" type="checkbox"/> Gravel Packed	<input type="checkbox"/> Underreamed	<input type="checkbox"/> Telescoped
<input type="checkbox"/> Natural Development	<input type="checkbox"/> Open Hole	<input type="checkbox"/> Other
(Describe) _____		
Top of Lap Pipe or Reduction in Casing		
FEET IF TELESCOPED OR MORE THAN ONE SCREEN: USE BACK PAGE		

LOG DATA					
TYPE OF LOG RUN (Circle One):					
<input type="checkbox"/> No Log Run	<input type="checkbox"/> Electric	<input type="checkbox"/> Gamma Ray	<input type="checkbox"/> Density	<input type="checkbox"/> Sonic	<input type="checkbox"/> Neutron
Other (Describe) _____					
Name of Organization Running Log					

SCREEN DATA		
Diameter - Inches	Length - Feet	Slot Size - Inches
4"	10'	0.13
Screen Type	Depth to Bottom - Feet	
PVC	10'	


GEOLOGIC DATA (Office Use Only)			
Surface Elev.	Geologic Unit	Unit Thickness	Depth to Top
Subs. SWL	Date	Analysis	Aquifer Test
Driller's Remarks			

DESCRIPTION OF FORMATIONS ENCOUNTERED	FROM	TO	FORMATIONS (Continued)	FROM	TO
RC.	0	30	<div style="border: 2px solid black; padding: 5px; font-size: 2em; font-weight: bold; transform: rotate(-15deg); display: inline-block;">RECEIVED</div> NOV 03 1989 Department of Natural Resources Bureau of Land & Water Resources		
RC & S	30	60			
SAND & GRAV	60	90			
RS	90	120			
WS	120	140			

IF MORE SPACE IS NEEDED, USE BACK

If well telescopes please
sketch and show depths.

GROUND LEVEL

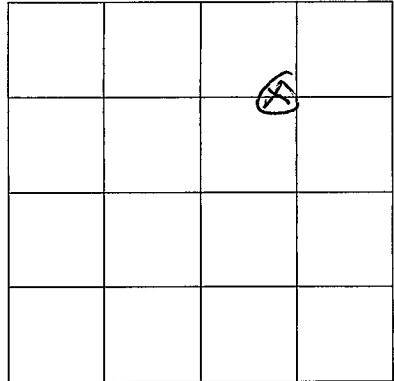

SECTION 29

Please indicate well location X.

ADDITIONAL INFORMATION

If more than one screen,
show location of each on sketch.