

MISSISSIPPI DEPARTMENT OF ENVIRONMENTAL QUALITY

Office of Land and Water Resources

P. O. Box 10631  
Jackson, MS 39289-0631  
WATER WELL DRILLERS LOG

COUNTY WELL LOCATED <u>TATE</u>	
WELL NUMBER <u>N 2057</u>	CODED
DATE WELL COMPLETED <u>8-18-95</u>	

PERMIT NUMBER <b>HICKS WELL CO.</b>
NAME OF DRILLING FIRM <u>BOX 157</u> <u>SENATOBIA, MS 38668</u>

NAME & MAILING ADDRESS OF LANDOWNER <u>Andy Finlander Lee</u> <u>P.O. 1121</u> <u>Senatobia MS.</u>			
WELL LOCATION: SEC	TOWNSHIP	RANGE	
<u>2</u>	<u>6</u>	<u>N 6 E</u>	
DISTANCE	DIRECTION	NEAREST TOWN	
<u>12</u> Miles	<u>SE</u>	of <u>Senatobia</u>	
OTHER LANDMARK			
WELL PURPOSE: <input checked="" type="checkbox"/> Home Irrigation, <input type="checkbox"/> Municipal, <input type="checkbox"/> Industrial, <input type="checkbox"/> Fish Pond, etc.			

PUMP DATA		
PUMP TYPE (Circle One): <input checked="" type="checkbox"/> Submersible, <input type="checkbox"/> Turbine, <input type="checkbox"/> Jet, <input type="checkbox"/> Flowing Well, Other (Describe) _____		
POWER TYPE (Circle One): <input checked="" type="checkbox"/> Electric, <input type="checkbox"/> Tractor, <input type="checkbox"/> Diesel, <input type="checkbox"/> Gasoline, <input type="checkbox"/> Butane, Other (Describe) _____ H/P <u>1/2</u>		
Pump Capacity (GPM) <u>10</u>	No. of Stages <u>9</u>	Setting Depth <u>80</u> FT.
PUMP TEST		
Well yielded _____ GPM with a drawdown of _____ ft. after _____ hours of pumping		

WELL DATA		
Well Depth <u>105</u>	Casing Diameter (In.) <u>4"</u>	Casing Length (Ft.) <u>95</u>
Type of Casing <u>PVC</u>	Hole Depth <u>105'</u>	Depth to Static Water Level <u>40'</u>

TYPE OF COMPLETION: (Circle One or More):  
 Gravel Packed,  Underreamed,  Telescoped,  
 Natural Development,  Open Hole,  Other  
(Describe) \_\_\_\_\_


WELL GROUTED TO A DEPTH OF 10 FEET  
Type Grout (circle one):  Cement,  Bentonite, or Mix

SCREEN DATA		
Diameter - Inches <u>4"</u>	Length - Feet <u>10'</u>	Slot Size - Inches <u>013</u>
Screen Type <u>PVC</u>	Depth to Bottom - Feet <u>10'</u>	

LOG DATA			
TYPE OF LOG RUN (Circle One): <input type="checkbox"/> No Log Run, <input type="checkbox"/> Electric, <input type="checkbox"/> Gamma Ray, <input type="checkbox"/> Density, <input type="checkbox"/> Sonic, <input type="checkbox"/> Neutron, Other (Describe) _____			
Name of Organization Running Log			


GEOLOGIC DATA (Office Use Only)			
Surface Elev.	Geologic Unit	Unit Thickness	Depth to Top
Subs. SWL	Date	Analysis	Aquifer Test
Driller's Remarks			
Top of Lap Pipe or Reduction in Casing			
FEET		IF TELESCOPED OR MORE THAN ONE SCREEN: USE BACK PAGE	

DESCRIPTION OF FORMATIONS ENCOUNTERED	FROM	TO
<u>Red Sand</u>	<u>0</u>	<u>20</u>
<u>White Sand</u>	<u>20</u>	<u>105</u>

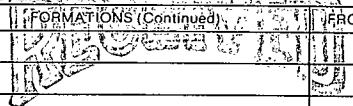FORMATIONS (Continued)		FROM	TO
			
<p><b>FEB 05 1996</b></p> <p>Dept. of Environmental Quality Office of Land &amp; Water Resources</p>			
IF MORE SPACE IS NEEDED, USE BACK			

If well telescopes please  
sketch and show depths.

GROUND LEVEL

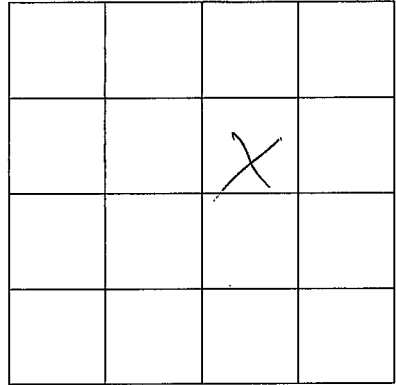

SECTION 2

Please indicate well location X.

ADDITIONAL INFORMATION

If more than one screen,  
show location of each on sketch.