

MISSISSIPPI DEPARTMENT OF ENVIRONMENTAL QUALITY

Office of Land and Water Resources

COUNTY WELL LOCATED TATE	
WELL NUMBER N 2066	CODED
DATE WELL COMPLETED 7-29-98	

PERMIT NUMBER HICKS WATER WELL CO.	
NO. OF DRILLING FEET 100	
ADDRESS 242 HWY. 4 EAST SENATOBIA, MS 38668	

P. O. Box 10631
Jackson, MS 39289-0631
WATER WELL DRILLERS LOG

NAME & MAILING ADDRESS OF LANDOWNER Henry Worley Jr.		
1527 Laurel Springs Rd.		
Senatobia, MS 38668		
WELL LOCATION: SEC	TOWNSHIP	RANGE
6	6 N	6 E
DISTANCE	DIRECTION	NEAREST TOWN
2 1/2 Miles	W	Loxahoma
OTHER LANDMARK		
WELL PURPOSE: Home Irrigation, Municipal, Industrial, Fish Pond, etc.		

PUMP DATA		
PUMP TYPE (Circle One): <input checked="" type="radio"/> Submersible, Turbine, Jet, Flowing Well, Other (Describe) _____		
POWER TYPE (Circle One): <input checked="" type="radio"/> Electric, Tractor, Diesel, Gasoline, Butane, Other (Describe) _____ H/P 1/2		
Pump Capacity (GPM)	No. of Stages	Setting Depth
10		100 FT.
PUMP TEST		
Well yielded no GPM with a drawdown of Feet ft. after _____ hours of pumping		

WELL DATA		
Well Depth	Casing Diameter (In.)	Casing Length (Ft.)
151	4	141
Type of Casing	Hole Depth	Depth to Static Water Level
PVC	151	70

LOG DATA	
TYPE OF LOG RUN (Circle One): <input checked="" type="radio"/> No Log Run, Electric, Gamma Ray, Density, Sonic, Neutron, Other (Describe) _____	
Name of Organization Running Log	

TYPE OF COMPLETION: (Circle One or More): <input checked="" type="radio"/> Gravel Packed, Underreamed, Telescoped, <input type="radio"/> Natural Development, <input type="radio"/> Open Hole, <input type="radio"/> Other (Describe) _____		
--	--	--

GEOLOGIC DATA (Office Use Only)			
Surface Elev.	Geologic Unit	Unit Thickness	Depth to Top
Subs. SWL	Date	Analysis	Aquifer Test

WELL GROUTED TO A DEPTH OF 3 FEET Type Grout (circle one): <input checked="" type="radio"/> Cement, Bentonite, or Mix

Driller's Remarks	
08-24-98 A09:44 KLVU	
Top of Lap Pipe or Reduction in Casing	
FEET	IF TELESCOPED OR MORE THAN ONE SCREEN: USE BACK PAGE


SCREEN DATA		
Diameter - Inches	Length - Feet	Slot Size - Inches
4	10	.013
Screen Type	Depth to Bottom - Feet	
PVC Slot	141'	

DESCRIPTION OF FORMATIONS ENCOUNTERED	FROM	TO	FORMATIONS (Continued)		
			FROM	TO	
Red Clay	0	10			
White clay & gravel	10	40			
White sand & clay	40	80			
White Sand	80	151			

IF MORE SPACE IS NEEDED, USE BACK

If well telescopes please
sketch and show depths.

GROUND LEVEL

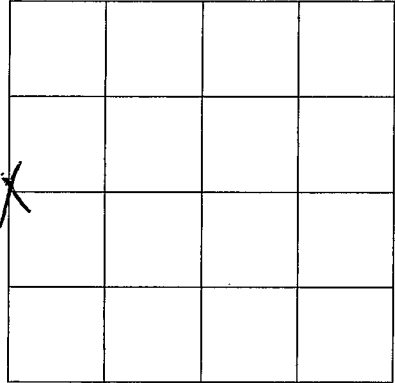

SECTION

6

Please indicate well location X.

ADDITIONAL INFORMATION

If more than one screen,
show location of each on sketch.