

TATE
 N 2097 N 1007
 5-5-78

MISSISSIPPI
 BOARD OF WATER COMMISSIONERS
 416 North State Street
 Jackson, Mississippi 39201

WATER WELL DRILLERS LOG

5-5-78 19 Bob Little Well Dr. Late
 date well completed firm name county well located

LANDOWNER:	description of formations encountered	from	to
<u>W.C. Wallace</u>			
<u>Lopham, M.</u> (mailing address)	<u>top soil</u>	<u>0</u>	<u>5</u>
	<u>red clay</u>	<u>5</u>	<u>40</u>
	<u>gravel</u>	<u>40</u>	<u>60</u>
	<u>sand</u>	<u>60</u>	<u>190</u>

WELL LOCATION:
 sec. 5 T. 6 N. R. 6 E
2 miles W of Loxahoma
 (distance) (direction) (nearest town)

WELL PURPOSE:
 (home, irrigation, municipal, industrial)

WELL COMPLETION DATA:

(1) diameter (inches) 6"

(2) total depth (feet) 190

(3) static water level (feet) 90 below top of ground

(4) casing plastic, 190
 (material) (depth)

(size) if telescope see back.

(5) screen 30, 160'
 (length) (depth to top)

4", plastic
 (size) (material)

(6) pump 5
 (HP) (yield gpm)

Electric
 (type power)

(7) electric log (yes or no)

(organization running log)

(8) how well bottom plugged


DRILLERS REMARKS:

RECEIVED
 NOV 27 1978

MISS. BD. OF WATER COMMISSIONERS

If well telescopes please sketch and show depths.

GROUND LEVEL

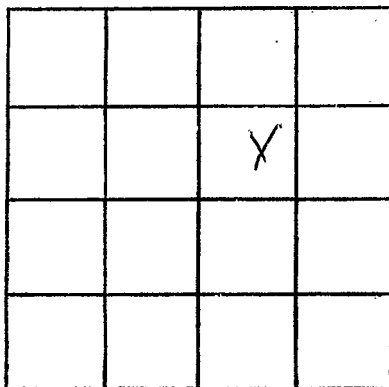

SECTION _____

Please indicate well location X.

ADDITIONAL INFORMATION

If more than one screen, show locations of each on sketch.