

TATE  
 01  
 4-6-71

MISSISSIPPI  
 BOARD OF WATER COMMISSIONERS  
 416 North State Street  
 Jackson, Mississippi 39201

**CODED**

WATER WELL DRILLERS LOG

4-6 1971 Harris Bros. Tate  
 date well completed firm name county well located

LANDOWNER: Jimmy  
 Crockett  
 Rt. 1 Senatobia  
 (mailing address)

description of formations encountered	from	to
top soil	0	20
sand + red clay	20	65
fine sand + w clay	65	185
Coarse sand	185	210

WELL LOCATION:  
 sec. 4 T-6 N R-5 E  
 1 1/2 miles W of Frys  
 (distance), (direction) (nearest town)

WELL PURPOSE: home  
 (home, irrigation, municipal, industrial)

- WELL COMPLETION DATA:
- (1) diameter (inches) 4
  - (2) total depth (feet) 210
  - (3) static water level (feet) 100 <sup>below</sup> above top of ground.
  - (4) casing Plastic, 196  
 (material) (depth)  
 4 (size) if telescope see back.
  - (5) screen 14' 196  
 (length) (depth to top)  
 008 Plastic  
 (size) (material)
  - (6) pump 3/4 7  
 (HP) (yield gpm)  
 elec.  
 (type power)
  - (7) electric log NO  
 (yes or no)

**CODED**

(organization running log)

(8) how well bottom plugged back  
 shot


MAY 14 1971

DRILLERS REMARKS:

MISS. BD. OF  
 WATER COMMISSIONERS

If well telescopes please sketch and show depths.

GROUND LEVEL

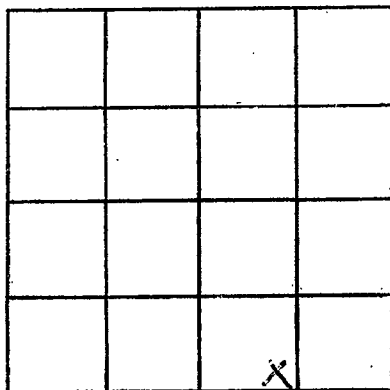

SECTION 4

Please indicate well location X.

ADDITIONAL INFORMATION

If more than one screen, show locations of each on sketch.