

TATE
 03
 1-25-73

MISSISSIPPI
 BOARD OF WATER COMMISSIONERS
 416 North State Street
 Jackson, Mississippi 39201

CODED

WATER WELL DRILLERS LOG

1-25-73 date well completed 19 Links & Sons Well Co. firm name Tate county well located


LANDOWNER: <u>Anderson</u>	description of formations encountered	from	to
<u>Garrett, Peter</u>	<u>Red Clay</u>	<u>0</u>	<u>15</u>
<u>Como, Miss</u>	<u>Red Sand</u>	<u>15</u>	<u>55</u>
(mailing address)	<u>White Clay</u>	<u>55</u>	<u>25</u>
WELL LOCATION: sec. <u>18</u> T. <u>6</u> N. R. <u>5</u> E. S. <u>5</u> W.	<u>White Sand & Clay</u>	<u>75</u>	<u>135</u>
_____ miles _____ of _____ (distance) (direction) (nearest town)	<u>White Sand</u>	<u>135</u>	<u>125</u>
WELL PURPOSE: <u>Dom</u> (home, irrigation, municipal, industrial)			
WELL COMPLETION DATA:			
(1) diameter (inches) <u>4 1/2</u> in.			
(2) total depth (feet) <u>175</u>			
(3) static water level (feet) <u>109</u> below above top of ground.			
(4) casing <u>Plastic</u> <u>175</u> (material) (depth)			
_____ if telescope see back. (size)			
(5) screen <u>4 1/2</u> <u>121</u> (length) (depth to top)			
<u>4 1/2</u> <u>Gravel</u> (size) (material)			
(6) pump <u>3/4</u> <u>1000</u> (HP) (yield gpm)			
<u>Electric</u> (type power)			
(7) electric log <u>No</u> (yes or no)			
_____ (organization running log)			
(8) how well bottom plugged <u>cap</u>			
DRILLERS REMARKS:			

CODED

FEB 27 1973

If well telescopes please
sketch and show depths.

GROUND LEVEL

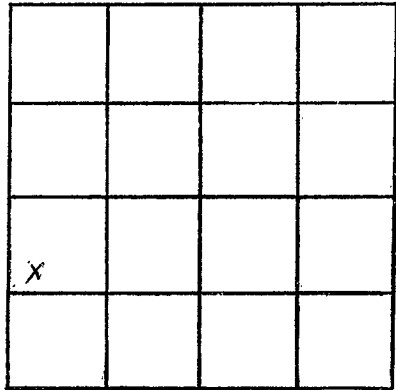

SECTION _____

Please indicate well location X.

ADDITIONAL INFORMATION

A series of 20 horizontal lines for writing additional information.

If more than one screen,
show locations of each on sketch.