

TATE  
 04  
 10-5-72

MISSISSIPPI  
 BOARD OF WATER COMMISSIONERS  
 416 North State Street  
 Jackson, Mississippi 39201

**CODED**

WATER WELL DRILLERS LOG

10-5-72 date well completed      Harris Bros. firm name      Tate county well located

LANDOWNER: Floyd Crockett

description of formations encountered

pt. 3

Senatobia  
 (mailing address)

	from	to
top soil	0	20
red sand	20	60

WELL LOCATION:  
 sec. 7 T. 6 N. R. 5 E.  
1 1/2 miles W of Lyno  
 (distance) (direction) (nearest town)

white clay sand	60	185
Coarse sand	185	210

WELL PURPOSE: home  
 (home, irrigation, municipal, industrial)

WELL COMPLETION DATA:

- (1) diameter (inches) 4
- (2) total depth (feet) 210
- (3) static water level (feet) 120 <sup>below</sup>/<sub>above</sub> top of ground.
- (4) casing Plastic, 196  
 (material) (depth)  
4 If telescope see back.  
 (size)
- (5) screen 14, 196  
 (length) (depth to top)  
008, Plastic  
 (size) (material)
- (6) pump 3/4, 10  
 (HP) (yield gpm)  
elec.  
 (type power)
- (7) electric log no  
 (yes or no)
- (organization running log)
- (8) how well bottom plugged solid

**CODED**


DRILLERS REMARKS:

MISS. 22 (REV. 1-23-72)

MISS. 22 OF WATER 2074

If well telescopes please sketch and show depths.

GROUND LEVEL

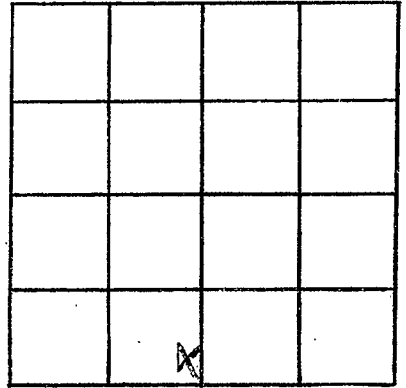

SECTION 4

Please indicate well location X.

ADDITIONAL INFORMATION

If more than one screen, show locations of each on sketch.