

TATE  
 05  
 5-27-73  
 5-27-73  
 0-06-00 19

MISSISSIPPI  
 BOARD OF WATER COMMISSIONERS  
 416 North State Street  
 Jackson, Mississippi 39201

**CODED**

WATER WELL DRILLERS LOG

*Blacksboro Wells*     *Tate*

date well completed

firm name

county well located

LANDOWNER:

*Danny Effe*

description of formations encountered

from to

*Rt 1, Senatobia, Miss*  
 (mailing address)

*Red Clay 0 15*  
*Red Sand 15 60*  
*White Sand 60 215*

WELL LOCATION:

sec. *9 T 6* N R *5* E  
                     S           W

*14* miles *S. E* of *SENATOBIA*  
 (distance) (direction) (nearest town)

WELL PURPOSE: *Home*  
 (home, irrigation, municipal, industrial)

WELL COMPLETION DATA:

- (1) diameter (inches) *4 1/2"*
- (2) total depth (feet) *215*
- (3) static water level (feet) *164* below above top of ground.
- (4) casing *Plastic, 215*  
 (material) (depth)

**CODED**

\_\_\_\_ if telescope see back.  
 (size)

- (5) screen *4* *161*  
 (length) (depth to top)
- 4 1/2"* *Gravel*  
 (size) (material)

- (6) pump *3/4* *10*  
 (HP) (yield gpm)
- Electric* *220*  
 (type power)

- (7) electric log *No*  
 (yes or no)

\_\_\_\_\_  
 (organization running log)

- (8) how well bottom plugged *Cap*


JUN 21 1973

DRILLERS REMARKS:

MISS. BO. OF  
 WATER COMMISSIONERS

If well telescopes please sketch and show depths.

GROUND LEVEL

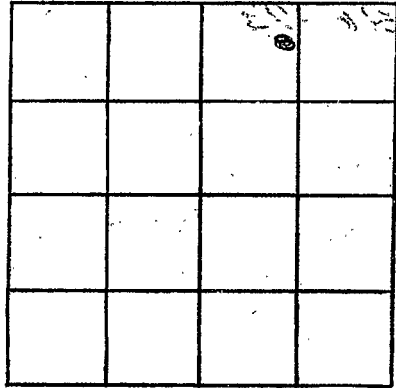

SECTION 9

Please indicate well location X.

ADDITIONAL INFORMATION

If more than one screen, show locations of each on sketch.