

LATE
 7
 6-26-73

MISSISSIPPI
 BOARD OF WATER COMMISSIONERS
 416 North State Street
 Jackson, Mississippi 39201

CODED

WATER WELL DRILLERS LOG

6-26 1973 Harris Bros. Late
 date well completed firm name county well located

LANDOWNER: J. J. Bromlitt
 7344 Macon Rd.
 Cordova, Tennessee
 (mailing address)

description of formations encountered	from	to
top soil	0	20
red sand	20	50
clay + sand	50	165
fine sand	165	190
coarse sand	190	210

WELL LOCATION:
 sec. 4 T. 6 N. R. 5 E
 1/2 miles NW of Juro
 (distance) (direction) (nearest town)

WELL PURPOSE: none
 (home, irrigation, municipal, industrial)

- WELL COMPLETION DATA:
- (1) diameter (inches) 4
 - (2) total depth (feet) 210
 - (3) static water level (feet) 120 ^{below} top of ground.
 - (4) casing Plastic, 196
 (material) (depth)
 4 If telescope see back.
 (size)
 - (5) screen 14, 196
 (length) (depth to top)
 008 Plastic
 (size) (material)
 - (6) pump 3/4 10
 (HP) (yield gpm)
 elec
 (type power)
 - (7) electric log NO
 (yes or no)
- (organization running log)
- (8) how well bottom plugged solid


CODED

DRILLERS REMARKS:

USE 92 1172

If well telescopes please sketch and show depths.

GROUND LEVEL

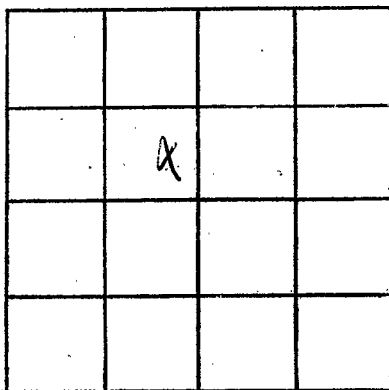

SECTION 4

Please indicate well location X.

ADDITIONAL INFORMATION

If more than one screen,
show locations of each on sketch.