

TATE
 08
 4-19-74

MISSISSIPPI
 BOARD OF WATER COMMISSIONERS
 416 North State Street
 Jackson, Mississippi 39201 CODED

WATER WELL DRILLERS LOG

4-19-1974 date well completed
 241000 Bono Well Co. firm name
 Tate county well located

LANDOWNER:
 William Ament Jr.
 Rt 1 Box 111, Senatobia
 (mailing address) Miss

description of formations encountered	from	to
Red Clay	0	15
White Sand & Clay	15	30
White Sand	30	145

WELL LOCATION:
 sec. 7 T. 6 N. R. 5 E
 3 miles E of Leno
 (distance) (direction) (nearest town)

WELL PURPOSE: Home
 (home, irrigation, municipal, industrial)

CODED

WELL COMPLETION DATA:


(1) diameter (inches) 4 1/2
 (2) total depth (feet) 145
 (3) static water level (feet) 80 below top of ground.
 (4) casing (material) Plastic, 145 (depth)
 (size) if telescope see back.
 (5) screen 4 ft, 141 (length) (depth to top)
 4 in. Gravel (size) (material)
 (6) pump 1/2 (HP) 3 (yield gpm)
 Electric 110 (type power)
 (7) electric log no (yes or no)
 (organization running log)
 (8) how well bottom plugged Cap

DRILLERS REMARKS:

APR 22 1974

If well telescopes please sketch and show depths.

GROUND LEVEL

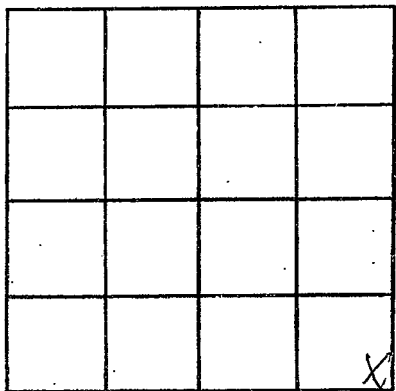

SECTION 2

Please indicate well location X.

ADDITIONAL INFORMATION

If more than one screen,
show locations of each on sketch.