

TATE  
09  
12-1-73

MISSISSIPPI  
BOARD OF WATER COMMISSIONERS  
416 North State Street  
Jackson, Mississippi 39201

CODED

WATER WELL DRILLERS LOG

12-1-1973 date well completed      Bob Smith firm name      Tate county well located


LANDOWNER:	description of formations encountered	from	to
Dale Cogel Tyrone, Miss. (mailing address)			
WELL LOCATION:	Red clay	5'	40'
sec. 2 T. 6 N. R. 5 E. S W	Red sand	40'	100'
In town of Tyrone (distance) miles (direction) of (nearest town)	White sand	100'	200'
WELL PURPOSE: Home (home, irrigation, municipal, industrial)			
WELL COMPLETION DATA:			
(1) diameter (inches) 4			
(2) total depth (feet) 200			
(3) static water level (feet) 130 below top of ground.			
(4) casing Plastic 200 (material) (depth)			
(size) If telescope see back.			
(5) screen 20' 180' (length) (depth to top)			
4' Plastic (size) (material)			
(6) pump 1 15 (HP) (yield gpm)			
E. Lee (type power)			
(7) electric log no (yes or no)			
(organization running log)			
(8) how well bottom plugged Plugged			
DRILLERS REMARKS:			

CODED

RECEIVED  
MAY 19 1974

If well telescopes please sketch and show depths.

GROUND LEVEL

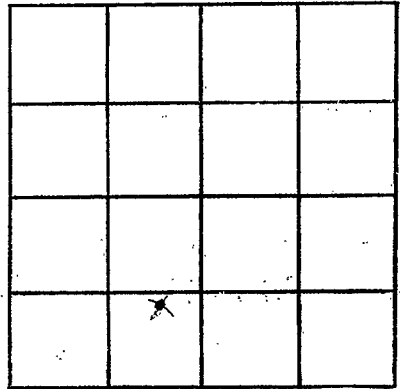

SECTION 2

Please indicate well location X.

ADDITIONAL INFORMATION

If more than one screen, show locations of each on sketch.