

TATE  
 010  
 7-2-74

MISSISSIPPI  
 BOARD OF WATER COMMISSIONERS  
 416 North State Street  
 Jackson, Mississippi 39201

CODED

WATER WELL DRILLERS LOG

7-2-1974 Hinds Board Well Co. Tate  
 date well completed firm name county well located

LANDOWNER:  
 S. M. White -  
 Senatobia, Miss.  
 (mailing address)

description of formations encountered	from	to
Red clay + white clay	0	30
white sand	30	75
white sand + clay	75	105
white sand	105	150
white sand + clay	150	165
white sand	165	202

WELL LOCATION:  
 sec. 11 T. 6 N. R. 5 E  
 1 miles SE of Lind  
 (distance) (direction) (nearest town)

WELL PURPOSE: drain  
 (home, irrigation, municipal, industrial)

WELL COMPLETION DATA:

(1) diameter (inches) 4 1/2  
 (2) total depth (feet) 202  
 (3) static water level (feet) 125 below top of ground.  
 (4) casing Plastic, 2 1/2 (material) (depth) (size) if telescope see back.  
 (5) screen 4 ft (length) 198 (depth to top) 4 1/2 (size) Shovel (material).  
 (6) pump 3/4 (HP) 10 (yield gpm) 220 (type power)  
 (7) electric log no (yes or no)  
 (organization running log)  
 (8) how well bottom plugged cap

CODED


RECEIVED

AUG - 2 1974

DRILLERS REMARKS:

If well telescopes please sketch and show depths.

GROUND LEVEL

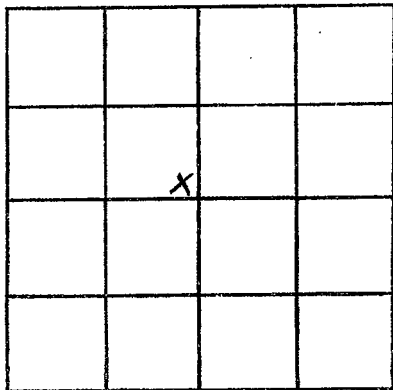

SECTION 11

Please indicate well location X.

ADDITIONAL INFORMATION

If more than one screen,  
show locations of each on sketch.