

DATE
Φ 11
12/79

MISSISSIPPI
BOARD OF WATER COMMISSIONERS
416 North State Street JACKSON, MISSISSIPPI 39201

WATER WELL DRILLERS LOG

19 79 date well completed Bob Smith & Son Well Drilling firm name Jate county well located

LANDOWNER: Harold Tucker
Jate, Miss.
(mailing address)

WELL LOCATION:
sec 12 T. 6 N. R. 5 E.
3 miles east of Jate
(distance) (direction) (nearest town)

WELL PURPOSE:
(home, irrigation, municipal, industrial)

- WELL COMPLETION DATA:
- (1) diameter (inches) 4
 - (2) total depth (feet) 253
 - (3) static water level (feet) 206 below above top of ground.
 - (4) casing plastic, 253'
(material) (depth)
(size) if telescope see back.
 - (5) screen 10, 196'
(length) (depth to top)
4, plastic
(size) (material)
 - (6) pump 3/4
(HP) (yield gpm)
electric
(type power)
 - (7) electric log NO
(yes or no)
 - (organization running log)
 - (8) how well bottom plugged plugged

description of formations encountered	from	to
<u>red sand & rock</u>	<u>0'</u>	<u>100'</u>
<u>red sand</u>	<u>100'</u>	<u>160'</u>
<u>sand & clay</u>	<u>160'</u>	<u>200'</u>
<u>fine sand</u>	<u>200'</u>	<u>230'</u>
<u>course sand</u>	<u>230'</u>	<u>250'</u>

CODED


DISCONTINUED
REVISED

DEC 19 1979

DRILLERS REMARKS:

If well telescopes please sketch and show depths.

GROUND LEVEL

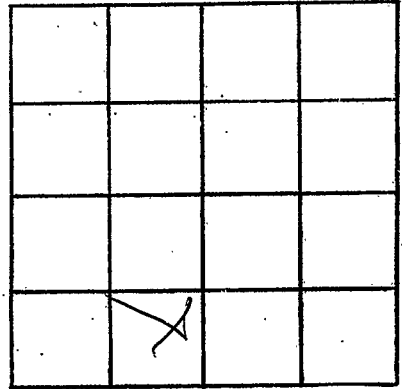

SECTION _____

Please indicate well location X.

ADDITIONAL INFORMATION

If more than one screen, show locations of each on sketch.