

Tate
 P 12
 6-21-75

MISSISSIPPI
 BOARD OF WATER COMMISSIONERS
 416 North State Street
 Jackson, Mississippi 39201

CODED

WATER WELL DRILLERS LOG


June 21 1975 North Miss Well Drilling Tate
 date well completed firm name county well located

LANDOWNER: <u>George Callcott</u> <u>Como</u>	description of formations encountered	from	to
(mailing address)	Clay	0	30
WELL LOCATION: sec. <u>9</u> T. <u>6</u> N. R. <u>5</u> E. <u>156</u> <u>12</u> miles <u>E</u> of <u>Como</u> (distance) (direction) (nearest town)	Sand	30	170
WELL PURPOSE: (home, irrigation, municipal, industrial)	CODED		
WELL COMPLETION DATA: (1) diameter (inches) <u>4"</u> (2) total depth (feet) <u>170</u> (3) static water level (feet) <u>140</u> below top of ground. (4) casing <u>Plastic</u> , <u>170</u> , (material) (depth) (size) If telescope see back. (5) screen <u>10'</u> , <u>160</u> (length) (depth to top) <u>4</u> , <u>Plastic</u> (size) (material) (6) pump <u>3/4</u> , <u>12</u> (HP) (y. fld. gpm) <u>Electric</u> (type power) (7) electric log <u>9/10</u> (yes or no) (organization running log) (8) how well bottom plugged <u>Plug</u>	RECEIVED JUN 24 1975 MISS. BOARD OF WATER COMMISSIONERS		
DRILLERS REMARKS:			

MISS. BOARD OF WATER COMMISSIONERS

If well telescopes please sketch and show depths.

GROUND LEVEL

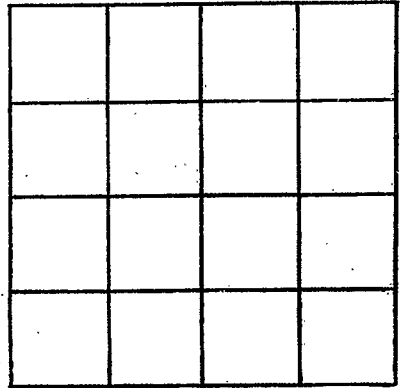

SECTION _____

Please indicate well location X.

ADDITIONAL INFORMATION

If more than one screen,
show locations of each on sketch.