

MISSISSIPPI DEPARTMENT OF NATURAL RESOURCES

Bureau of Land and Water Resources

Southport Mall

P.O. Box 10631

Jackson, Mississippi 39209

WATER WELL DRILLERS LOG

CODED

Φ13
 TATE
 1-28-84

1-7-84 date well completed 19 Bullitt Well Drilling firm name Tate county well located

LANDOWNER: John Rogers Church
 (mailing address)
 WELL LOCATION:
 sec. 3 T. 6 N R. 54 E
 (distance) miles (direction) of Tyrone (nearest town)

description of formations encountered	from	to
Top soil	0	4
red clay	4	25
white sand and clay	25	160
sand white	160	180

WELL PURPOSE:
 (home, irrigation, municipal, industrial)

WELL COMPLETION DATA:

(1) diameter (inches) 4

(2) total depth (feet) 180

(3) static water level (feet) 160 below above top of ground.

(4) casing PVC (material), 120 (depth),
 (size) if telescope see back.

(5) screen 10 (length), 170 (depth to top)
4 1/2 (size), PVC (material)

(6) pump 3 (HP), 10 (yield gpm)
Electric (type power)

(7) electric log no (yes or no)
 (organization running log)

(8) how well bottom plugged cap

DEPT. OF NATURAL RESOURCES
 BUREAU OF LAND & WATER RESOURCES


APR 26 1984

RECEIVED

DRILLERS REMARKS:

If well telescopes please sketch and show depths.

GROUND LEVEL

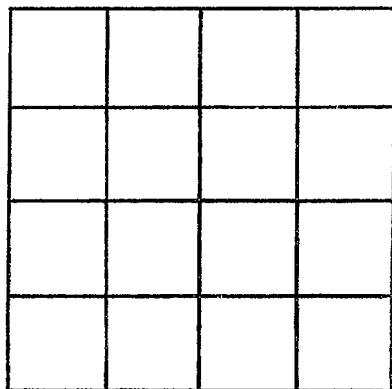

SECTION _____

Please indicate well location X.

ADDITIONAL INFORMATION

If more than one screen,
show locations of each on sketch.