

TATE
 017
 6-25-70

MISSISSIPPI
 BOARD OF WATER COMMISSIONERS
 416 North State Street
 Jackson, Mississippi 39201

CODED

WATER WELL DRILLERS LOG

6-25 19 70 Harris Bros. Tate
 date well completed firm name county well located

LANDOWNER: Rosemarie Jant
 Rt. 1
 Senatobia
 (mailing address)

description of formations encountered	from	to
top soil	0	20
red sand	20	65
clay and fine sand	65	160
fine sand	160	200
coarse sand	200	220

WELL LOCATION:
 sec. 11 T 6 N R 5 E
 1/2 miles E of Tins
 (distance) (direction) (nearest town)

WELL PURPOSE: home
 (home, irrigation, municipal, industrial)

- WELL COMPLETION DATA:
- (1) diameter (inches) 4
 - (2) total depth (feet) 220
 - (3) static water level (feet) 120 ^{below} above top of ground.
 - (4) casing Plastic, 206
 (material) (depth)
 4 if telescope see back.
 (size)
 - (5) screen 14', 206
 (length) (depth to top)
 #08 Plastic
 (size) (material)
 - (6) pump 3/4, 10
 (HP) (yield gpm)
 elec.
 (type power)
 - (7) electric log no
 (yes or no)
- (organization running log)

CODED

(8) how well bottom plugged
 shut back


DRILLERS REMARKS:

NOV 12 1970

MISS. BD. OF
 WATER COMM.

If well telescopes please sketch and show depths.

GROUND LEVEL

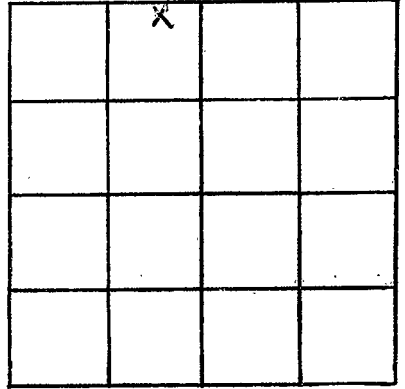

SECTION 11

Please indicate well location X.

ADDITIONAL INFORMATION

If more than one screen,
show locations of each on sketch.