


If well telescopes please sketch and show depths.

DATE

50-55-11

GROUND LEVEL

8
 01 0 well at 10' + 10' 2
 03 01 2-2 at 10' + 10'
 05 03 well at 10' + 10'
 06 03 2-2 at 10'

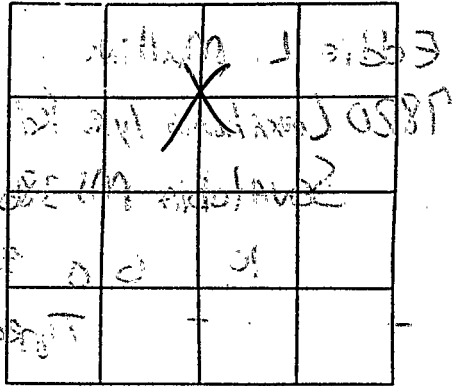

SECTION 10

Please indicate well location X.

Pump Capacity (GPM) <u>25</u>	No. of Stages	Setting Depth <u>200</u> FT.
PUMP TEST		
Well yielded	<u>NO TEST</u>	<u>25</u> GPM with
a drawdown of		<u>10</u> ft.
after	<u>01</u>	hours of pumping

LOG DATA

TYPE OF LOG RUN (Circle One):
 Electric, Gamma Ray, Density, Sonic, No Log Run, Neutron,
 Other (Describe)

Name of Organization Running Log

GEOLOGIC DATA (Office Use Only)

Surface Elev.	Geologic Unit	Unit Thickness	Depth to Top
Subs. SWL	Date	Analysis	Aquifer Test

Driller's Remarks

If more than one screen, show location of each on sketch.

50-55-51

255-0