

WATER WELL DRILLERS LOG

Date: May, 1961, Driller: Lamar Crockett County: Tate
(Name)

(1) Owner of Land: H. F. Coff.
(Name)
Rt. 1 Scatesboro
(Address)

(2) Location: 1/4, 1/4, Sec. 9 T6 R5
1/4 miles West, of Turo
(distance) (direction) (Nearest Town)

(3) Topography: X
(Hilly) (Flat) (Level)

(4) Purpose of Well: Home
(Domestic Irrigation, Municipal, Industrial, Other)

Description & Color of Materials Sand, Clay, Red Clay, Shell, etc.	Thick- ness Feet	Depth Feet
<u>Mix of</u>		
<u>Red & white sand</u>	<u>20</u>	<u>6</u>

Information upon completion of well:

(1) Diameter 2 inches.

(2) Total Depth 206 feet.

(3) Water Level 175 feet below top of ground.

(4) Cased to _____, Size _____


(5) Screen: Size 6, Length 6 ft

(6) Were any formations sealed against pollution?
_____ yes, X no.

If YES depth of formation _____

Why _____

Drillers Remarks: _____

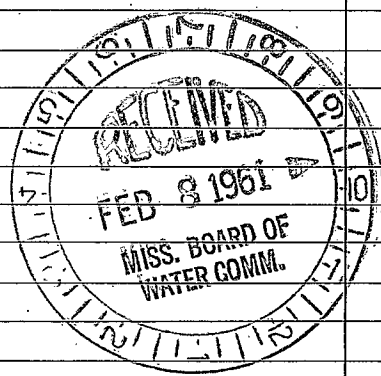

Well No.

(Use Back Side)

