

TATE
02001
7-66

MISSISSIPPI BOARD OF WATER COMMISSIONERS

WATER WELL DRILLERS LOG

Date: July, 19 66, Driller: Hanig, Brian County Jute
(When well drilled) (Name) (Where well is located)

(1) Owner of Land: L.D. Cathey
(Name)
Lyno Miss.
(Address)

(2) Location: 1/4, 1/4, Sec. 3 65 T. 5 R. 4
1/4 miles East, of Lyno
(distance) (direction) (Nearest Town)

(3) Topography: hilly
(Hilly) (Flat) (Level)

(4) Purpose of Well: domestic
(Domestic Irrigation
Municipal, Industrial, Other)

Information upon completion of well:

- (1) Diameter 4 inches.
(2) Total Depth 220 feet.
(3) Water Level 120 feet below top of ground.
(4) Cased to 206, Size 4"
(5) Screen: Size 4", Length 14'
(6) Were any formations sealed against pollution?
_____ yes, ✓ no.

If YES depth of formation _____

Why _____


Drillers Remarks: _____

Yield in gpm: 10

Size pump: 3/4 horse

Type power: electric

Description & Color of Materials Sand, Clay, Red Clay, Shell, etc.	Thick- ness Feet	Depth Feet
<u>top soil</u>	<u>6</u>	<u>20</u>
<u>R. Sand</u>	<u>20</u>	<u>40</u>
<u>W. clay and W. sand</u>	<u>40</u>	<u>160</u>
<u>fine sand</u>	<u>160</u>	<u>200</u>
<u>W. sand</u>	<u>200</u>	<u>220</u>

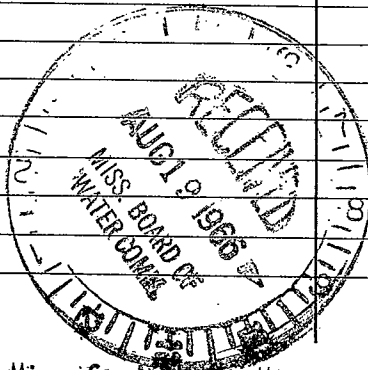

Mail this copy to Board of Water Commissioners 429 Miss. St. Jackson, Miss.

