

Tate
 2002
 5-20-76

MISSISSIPPI
 BOARD OF WATER COMMISSIONERS
 416 North State Street
 15E Jackson, Mississippi 39201

WATER WELL DRILLERS LOG

May 20 19 76 J. LEON WHITE TATE
 date well completed firm name county well located

LANDOWNER:
 J. B. GOLDEN
 Rt. 1, Box 73 Senatobia, Miss.
 (mailing address)

description of formations encountered	from	to
TOP SOIL	0	16
RED SAND	16	45
YELLOW CLAY	45	58
FINE WHITE SAND	58	80
COARSE WHITE SAND	80	95

WELL LOCATION:
 sec. 7 T 6 N R 5 E
 9 miles E. of SENATOBIA
 (distance) (direction) (nearest town)

WELL PURPOSE: FARM
 (home, irrigation, municipal, industrial)

WELL COMPLETION DATA:


(1) diameter (inches) 4"
 (2) total depth (feet) 95'
 (3) static water level (feet) 48' below above top of ground.
 (4) casing PLASTIC 89' (material) (depth)
 4" (size) if telescope see back.
 (5) screen 6' 95' (length) (depth to top)
 4" (size) IRONEL PACK (INSIDE) (material)
 (6) pump 1/2 10 (HP) (yield gpm)
 FLE. (type power)
 (7) electric log NO. (yes or no)
 (organization running log)
 (8) how well bottom plugged STRAINER

DRILLERS REMARKS:

MISS. BO. OF WATER COMMISSIONERS
 JUN 1 1976

If well telescopes please sketch and show depths.

GROUND LEVEL

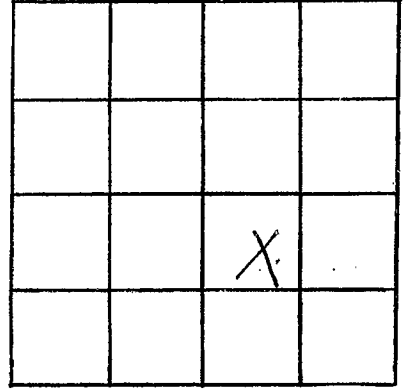

SECTION 7

Please indicate well location X.

ADDITIONAL INFORMATION

If more than one screen,
show locations of each on sketch.