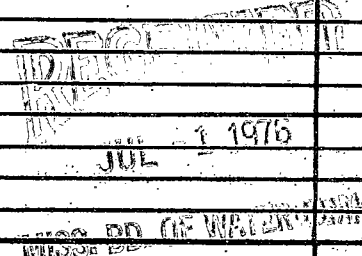


Date
 2003
 5-11-76

MISSISSIPPI
 BOARD OF WATER COMMISSIONERS
 416 North State Street
 15F Jackson, Mississippi 39201


WATER WELL DRILLERS LOG

5-11-1976 date well completed
 Hicks Well Co. firm name
 Tate county well located

LANDOWNER: <u>Frank Kinnaman</u> Pt. 1	description of formations encountered	from	to
Come, Miss. (mailing address)	Red Sand	0	35
WELL LOCATION:	Rock	35	36
sec. <u>14</u> T- <u>6</u> N R- <u>5</u> E 1 miles S of <u>Tyro</u> (distance) (direction) (nearest town)	Black Clay + Sand	36	100
WELL PURPOSE: <u>Home</u> (home, irrigation, municipal, industrial)	Rock	100	105
WELL COMPLETION DATA: (1) diameter (inches) <u>4"</u> (2) total depth (feet) <u>220</u> (3) static water level (feet) <u>120</u> below above top of ground. (4) casing <u>Plastic, 220</u> (material) (depth) (size) If telescope see back. (5) screen <u>4'</u> , <u>216</u> (length) (depth to top) <u>4"</u> , <u>Dravel</u> (size) (material) (6) pump <u>42</u> <u>10</u> (HP) (yield gpm) <u>220</u> (type power) (7) electric log <u>No</u> (yes or no) (organization running log) (8) how well bottom plugged <u>Cap</u>	White Sand	105	220
DRILLERS REMARKS:			

If well telescopes please sketch and show depths.

GROUND LEVEL

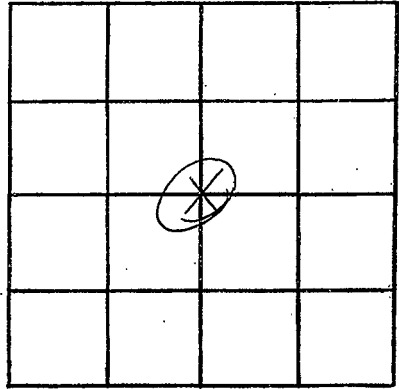

SECTION 14

Please indicate well location X.

ADDITIONAL INFORMATION

If more than one screen, show locations of each on sketch.