

Tate
 \$ 2005
 8-19-76

MISSISSIPPI
 BOARD OF WATER COMMISSIONERS
 416 North State Street
 15E Jackson, Mississippi 39201

WATER WELL DRILLERS LOG

8-19-76 1976 date well completed Slicks Well Co. firm name TATE county well located


| LANDOWNER: Robert C. Russell Rt. 1 | description of formations encountered | from | to |
|--|---------------------------------------|------|-----|
| Senatobia, Miss (mailing address) | Red Sand | 0 | 40 |
| | White Sand | 40 | 120 |
| | White Sand + Clay | 120 | 160 |
| | White Sand | 160 | 200 |
| WELL LOCATION: sec. <u>9</u> T. <u>6</u> N. R. <u>5</u> E <u>1/2</u> miles <u>W</u> of <u>Tynd</u> (distance) (direction) (nearest town) | | | |
| WELL PURPOSE: <u>Home</u> (home, irrigation, municipal, industrial) | | | |
| WELL COMPLETION DATA: | | | |
| (1) diameter (inches) <u>4"</u> | | | |
| (2) total depth (feet) <u>200</u> | | | |
| (3) static water level (feet) <u>120</u> below above top of ground. | | | |
| (4) casing <u>PVC</u> , <u>200</u> , (material) (depth) | | | |
| (size) If telescope see back. | | | |
| (5) screen <u>4"</u> , <u>196</u> (length) (depth to top) | | | |
| <u>4"</u> , <u>Shovel</u> (size) (material) | | | |
| (6) pump <u>1/2</u> , <u>10</u> (HP) (yield.gpm) | | | |
| <u>220V</u> (type power) | | | |
| (7) electric log <u>NO</u> (yes or no) | | | |
| (organization running log) | | | |
| (8) how well bottom plugged <u>Cap</u> | | | |
| DRILLERS REMARKS: | | | |

RECEIVED
 OCT - 5 1976

MISS. BD. OF WATER COMM.

If well telescopes please sketch and show depths.

GROUND LEVEL

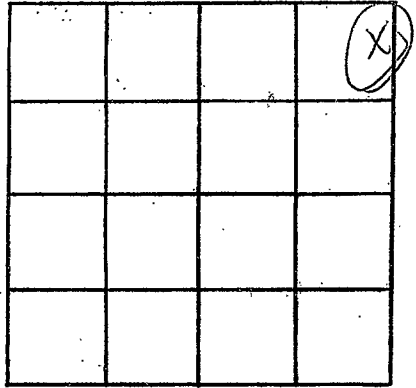

SECTION 9

Please indicate well location X.

ADDITIONAL INFORMATION

If more than one screen,
show locations of each on sketch.