

Jate
0 2000
10-18-76

MISSISSIPPI
 BOARD OF WATER COMMISSIONERS
 416 North State Street
 Jackson, Mississippi 39201

WATER WELL DRILLERS LOG

10-18 1976 Jate Holl Co.
 date well completed firm name county well located


LANDOWNER: <u>Jessie Todd</u>	description of formations encountered	from	to
<u>Senatobia, Mo.</u> (mailing address)			
WELL LOCATION: sec. <u>5</u> T. <u>6</u> N R. <u>5</u> E <u>2 1/2</u> miles <u>W</u> of <u>Turo</u> (distance) (direction) (nearest town)	<u>Red Clay</u>	<u>0</u>	<u>10</u>
	<u>Red Sand</u>	<u>10</u>	<u>30</u>
	<u>White Clay + Sand</u>	<u>30</u>	<u>65</u>
	<u>White Clay</u>	<u>65</u>	<u>90</u>
	<u>White Sand + Clay</u>	<u>90</u>	<u>115</u>
	<u>White Sand</u>	<u>115</u>	<u>135</u>
WELL PURPOSE: <u>Home</u> (home, irrigation, municipal, industrial)			
WELL COMPLETION DATA: (1) diameter (inches) <u>4</u> (2) total depth (feet) <u>135</u> (3) static water level (feet) <u>20</u> below/above top of ground. (4) casing <u>PVC</u> / <u>135</u> (material) (depth) (size) If telescope see back. (5) screen <u>7'</u> / <u>128'</u> (length) (depth to top) <u>4"</u> / <u>Dravel type</u> (size) (material) (6) pump <u>1/2</u> / <u>10</u> (HP) (yield gpm) <u>220V</u> (type power) (7) electric log <u>No</u> (yes or no) (organization running log) (8) how well bottom plugged <u>Cap</u>			
DRILLERS REMARKS:			

RECEIVED

JAN 5 1977

If well telescopes please sketch and show depths.

GROUND LEVEL

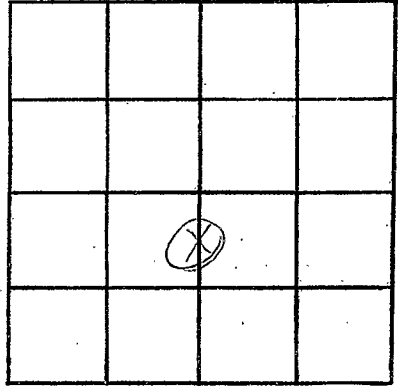

SECTION 5

Please indicate well location X.

ADDITIONAL INFORMATION

If more than one screen, show locations of each on sketch.