

TATE
 2007
 4-11-77

MISSISSIPPI
 BOARD OF WATER COMMISSIONERS
 416 North State Street
 Jackson, Mississippi 39201

WATER WELL DRILLERS LOG

4-11-77 date well completed 156 77 Bicks Well Co. firm name Tate county well located

LANDOWNER: Selma Hambl
 P.O.
 Senatobia, Mo.
 (mailing address)

description of formations encountered	from	to
	Red Clay	0
Red Sand	10	30
Red Chert Sand	30	90
White Sand	90	130

WELL LOCATION:
 sec. 5 T-6 N R-5 E
 2 1/2 miles W of Tyro
 (distance) (direction) (nearest town)

WELL PURPOSE: Home
 (home, irrigation, municipal, industrial)

- WELL COMPLETION DATA:
- (1) diameter (inches) 4
 - (2) total depth (feet) 130
 - (3) static water level (feet) 80 below top of ground.
 - (4) casing PVC 130 (material) (depth)
 - (size) If telescope see back.
 - (5) screen 4' 126' (length) (depth to top)
 - 4" gravel type (size) (material)
 - (6) pump 1/2 10 (HP) (yield gpm)
 - 220V (type power)
 - (7) electric log NO (yes or no)

(organization running log)
 (8) how well bottom plugged Cap


DRILLERS REMARKS:

RECEIVED
 MAY 13 1977

MISS. RD. OF WATER COMMISSIONERS

If well telescopes please sketch and show depths.

GROUND LEVEL

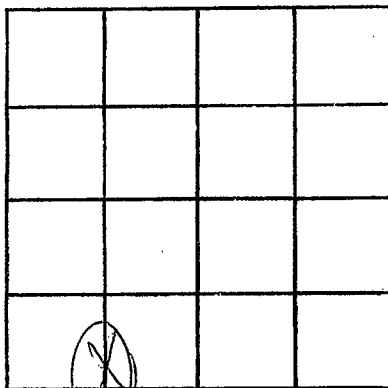

SECTION 5

Please indicate well location X.

ADDITIONAL INFORMATION

If more than one screen, show locations of each on sketch.