

TATE
 2007
 7-11-77

MISSISSIPPI
 BOARD OF WATER COMMISSIONERS
 416 North State Street
 156 Jackson, Mississippi 39201

WATER WELL DRILLERS LOG

7-11-77 19 date well completed
 Hicks Well Co firm name
 TATE county well located

LANDOWNER: Calvin Crockett
Rt. 1 Donata, Miss
 (mailing address)

WELL LOCATION:
 sec. 5 T. 6 N R. 5 E
 (distance) miles of 7.10 (direction) (nearest town)

WELL PURPOSE: STOR
 (home, irrigation, municipal, industrial)

- WELL COMPLETION DATA:
- (1) diameter (inches) 4"
 - (2) total depth (feet) 188
 - (3) static water level (feet) 160 below top of ground.
 - (4) casing Pvc, 181,
 (material) (depth)
 (size) if telescope see back.
 - (5) screen 7', 7'
 (length) (depth to top)
4", Inconel mesh
 (size) (material)
 - (6) pump 3/4", 10
 (HP) (yield gpm)
Elec
 (type power)
 - (7) electric log _____
 (yes or no)
 - _____ (organization running log)
 - (8) how well bottom plugged cap

| description of formations encountered | from | to |
|---------------------------------------|------|-----|
| Red Clay | 0 | 40 |
| Red sand | 40 | 50 |
| W.S | 50 | 110 |
| P.S | 110 | 160 |
| W.S | 160 | 188 |


RECEIVED
 AUG 19 1977

MISS. BD. OF WATER COMMISSIONERS

DRILLERS REMARKS:

If well telescopes please sketch and show depths.

GROUND LEVEL

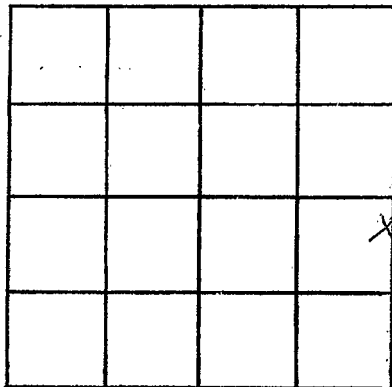

SECTION _____

Please indicate well location X.

ADDITIONAL INFORMATION

If more than one screen, show locations of each on sketch.