

Date
 2010
 10/27/77

MISSISSIPPI
 BOARD OF WATER COMMISSIONERS
 416 North State Street
 15E Jackson, Mississippi 39201

WATER WELL DRILLERS LOG

10-27-77 date well completed Kick Well Co. firm name Tate county well located

LANDOWNER: Howard Brown
Ret.
Senatobia, Miss.
 (mailing address)

description of formations encountered	from	to
Red clay	0	15
Red clay + sand	15	120
white sand	120	167

WELL LOCATION:
 sec. 6 T. 6 N. R. 6 E. 5
14 miles SE of Senatobia
 (distance) (direction) (nearest town)

WELL PURPOSE: Home
 (home, irrigation, municipal, industrial)

WELL COMPLETION DATA:

(1) diameter (inches) 4"

(2) total depth (feet) 167

(3) static water level (feet) 90 below above top of ground.

(4) casing PVC, 167,
 (material) (depth)
 (size) if telescope see back.

(5) screen 7 1/2', 160
 (length) (depth to top)
4', gravel type
 (size) (material)

(6) pump 1/2 10
 (HP) (yield gpm)
220V
 (type power)

(7) electric log no
 (yes or no)

(organization running log)

(8) how well bottom plugged cap


DRILLERS REMARKS:

RECEIVED
 NOV - 7 1977

MISS. BD. OF WATER COMMISSIONERS

If well telescopes please sketch and show depths.

GROUND LEVEL

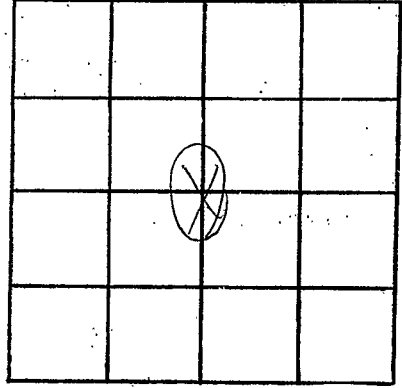

SECTION *C*

Please indicate well location X.

ADDITIONAL INFORMATION

If more than one screen, show locations of each on sketch.