

TATE
0 2011

**MISSISSIPPI
BOARD OF WATER COMMISSIONERS**
416 North State Street
Jackson, Mississippi 39201

WATER WELL DRILLERS LOG

5-11 1978 Hicks Well Co. Tate
 date well completed firm name county well located

LANDOWNER: Robert D. Meyman description of formations encountered from to
Pl. 1
Senatobia, Ms. Red clay 0 20
 (mailing address) Red sand 20 100

WELL LOCATION:
 sec. 6 T. 6 N. R. 5 E. White sand 100 130
5 miles E of Lookhome
 (distance) (direction) (nearest town)

WELL PURPOSE: Home
 (home, irrigation, municipal, industrial)

WELL COMPLETION DATA:

(1) diameter (inches) 4"

(2) total depth (feet) 130

(3) static water level (feet) 60 below above top of ground.

(4) casing PVC 130
 (material) (depth)

 If telescope see back.
 (size)

(5) screen 7' 123
 (length) (depth to top)

4" gravel type
 (size) (material)

(6) pump 1/2 10
 (HP) (yield gpm)

2200
 (type power)

(7) electric log No
 (yes or no)

 (organization running log)

(8) how well bottom plugged Cap

RECEIVED


MAY 30 1978

DRILLERS REMARKS: _____

MISS. BD. OF WATER COMM

If well telescopes please sketch and show depths.

GROUND LEVEL

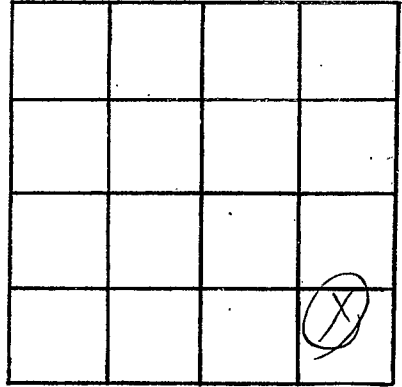

SECTION 6

Please indicate well location X.

ADDITIONAL INFORMATION

If more than one screen,
show locations of each on sketch.