

Tate  
 O 2014  
 10-30-79

MISSISSIPPI  
 BOARD OF WATER COMMISSIONERS  
 416 North State Street  
 Jackson, Mississippi 39201

WATER WELL DRILLERS LOG

10-30 date well completed 19 79 firm name Deeks Well Co. county well located Tate

LANDOWNER:  
H.P. Elder  
Rt. 1, Senatobia  
 (mailing address)

description of formations encountered	from	to
Red Clay	0	30
White Clay	30	90
red sand	90	170
white sand	170	230

WELL LOCATION:  
 sec. 12 T. 6 N. R. 5 E  
2 miles E of Tyro  
 (distance) (direction) (nearest town)

WELL PURPOSE: Home  
 (home, irrigation, municipal, industrial)

- WELL COMPLETION DATA:
- (1) diameter (inches) 4 in
  - (2) total depth (feet) 230
  - (3) static water level (feet) \_\_\_\_\_ below above top of ground.
  - (4) casing Plastic 230  
 (material) (depth)  
 (size) if telescope see back.
  - (5) screen 4 in 223  
 (length) (depth to top)  
Gravel  
 (size) (material)
  - (6) pump 1/2 10  
 (HP) (yield gpm)  
220  
 (type power)
  - (7) electric log No  
 (yes or no)

(organization running log)  
 (8) how well bottom plugged Comp


DRILLERS REMARKS:

DEPT. OF NATURAL RESOURCES  
 BUREAU OF LAND & WATER RESOURCES

NOV 13 1979  
 RECEIVED

If well telescopes please sketch and show depths.

GROUND LEVEL

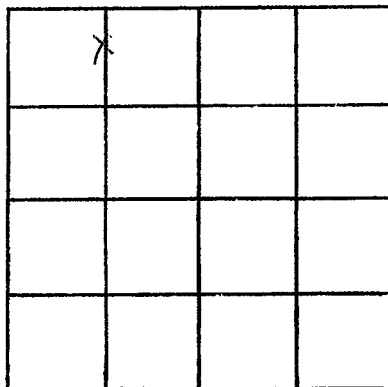

SECTION 12

Please indicate well location X.

ADDITIONAL INFORMATION

If more than one screen, show locations of each on sketch.