

Late
Q 2015
5-9-79

MISSISSIPPI
 BOARD OF WATER COMMISSIONERS
 416 North State Street
 Jackson, Mississippi 39201

WATER WELL DRILLERS LOG

5-9-79 19 Dicks Well Co. Late
 date well completed firm name county well located

LANDOWNER:
James Barclay
Rt. 1, Senatobia Miss.
 (mailing address)

description of formations encountered	from	to
<u>Red Clay</u>	<u>0</u>	<u>20</u>
<u>Red Clay & Red Sand</u>	<u>20</u>	<u>80</u>
<u>Red & Sand</u>	<u>80</u>	<u>110</u>
<u>Imperial White Sand</u>	<u>110</u>	<u>170</u>

WELL LOCATION:
 sec. 5 T. 6 N. R. 5 E
 (distance) (direction) (nearest town)

WELL PURPOSE: home
 (home, irrigation, municipal, industrial)

WELL COMPLETION DATA:

(1) diameter (inches) 4 in

(2) total depth (feet) 170 ft

(3) static water level (feet) _____ below above top of ground.

(4) casing Plastic, 170
 (material) (depth)

(size) If telescope see back.

(5) screen 4 in, 163 ft
 (length) (depth to top)

4 in, Gravel
 (size) (material)

(6) pump 1/2, 10
 (HP) (yield gpm)

220
 (type power)

(7) electric log No
 (yes or no)

(organization running log)

(8) how well bottom plugged Cap

DRILLERS REMARKS:


Miss. Board of Water Comm.

MAY 14 1979

RECEIVED

If well telescopes please sketch and show depths.

GROUND LEVEL

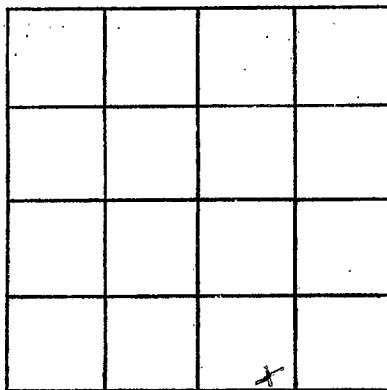

SECTION 5

Please indicate well location X.

ADDITIONAL INFORMATION

If more than one screen, show locations of each on sketch.