

MISSISSIPPI DEPARTMENT OF NATURAL RESOURCES

Bureau of Land and Water Resources

Southport Mall

P.O. Box 10631

Jackson, Mississippi 39209

WATER WELL DRILLERS LOG

Late
Ø 2016
4-28-81

4-28-1981 date well completed      Hicks Well Co. firm name      Late county well located

LANDOWNER: Geo. Johnson  
Ret. 1  
Skematolia, Mo  
 (mailing address)

description of formations encountered	from	to
Red Sand	0	50
White Sand	50	232

WELL LOCATION:  
 sec. 10 T. 6 N. R. 5 E.  
1 miles (distance) of Tyrod (direction) (nearest town)

WELL PURPOSE: Home  
 (home, irrigation, municipal, industrial)

WELL COMPLETION DATA:

(1) diameter (inches) 4"

(2) total depth (feet) 232

(3) static water level (feet) 180 below top of ground.

(4) casing P.V.C. 232  
 (material) (depth)

     if telescope see back.  
 (size)


(5) screen 12 220  
 (length) (depth to top)

4" crow type  
 (size) (material)

(6) pump 3/4 10  
 (HP) (yield gpm)

220V  
 (type power)

(7) electric log. No  
 (yes or no)

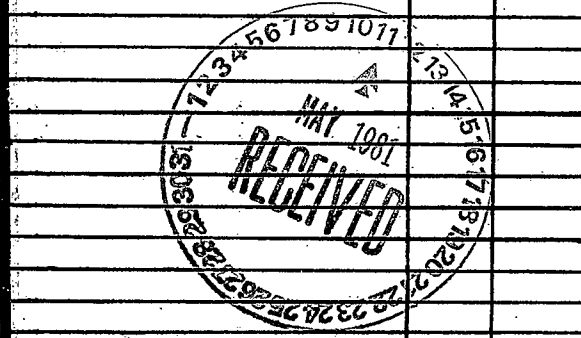


(organization running log)

(8) how well bottom plugged Cup

DRILLERS REMARKS:

If well telescopes please sketch and show depths.

GROUND LEVEL

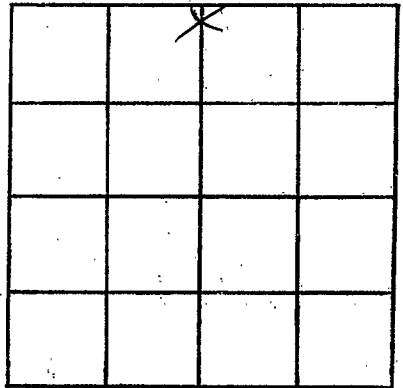

SECTION 10

Please indicate well location X.

ADDITIONAL INFORMATION

If more than one screen,  
show locations of each on sketch.