

MISSISSIPPI DEPARTMENT OF NATURAL RESOURCES
Bureau of Land and Water Resources
 Southport Mall
 P.O. Box 10631
 Jackson, Mississippi 39209
WATER WELL DRILLERS LOG

Date
02018

5-12 1983
 date well completed

HICKS WELL CO.
RT. 1, BOX 157

Tate
 county well located

LANDOWNER: Rosie Hibdon
Rt. 1
Como, Miss. 38619
 (mailing address)

description of formations encountered	from	to
<u>Red Clay</u>	<u>0</u>	<u>20</u>
<u>Red Sand</u>	<u>20</u>	<u>50</u>
<u>White Sand + clay</u>	<u>50</u>	<u>100</u>
<u>White Sand</u>	<u>100</u>	<u>260</u>

WELL LOCATION:
 sec. 9 T 6 N R. 5 E
1 miles S of Tyrone
 (distance) (direction) (nearest town)

WELL PURPOSE: Home
 (home, irrigation, municipal, industrial)

- WELL COMPLETION DATA:
- (1) diameter (inches) 4
 - (2) total depth (feet) 260
 - (3) static water level (feet) 180 below top of ground.
 - (4) casing PVC, 260,
 (material) (depth)
4 if telescope see back.
 (size)
 - (5) screen 10', 250'
 (length) (depth to top)
.013, PVC
 (size) (material)
 - (6) pump 3/4, 10
 (HP) (yield gpm)
220V
 (type power)
 - (7) electric log No
 (yes or no)
- (organization running log)

(8) how well bottom plugged Cap

DRILLERS REMARKS:


DEPT. OF NATURAL RESOURCES
 BUREAU OF LAND & WATER RESOURCES

MAY 25 1983

RECEIVED

If well telescopes please sketch and show depths.

GROUND LEVEL

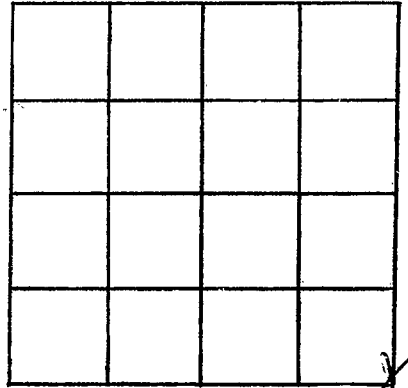

SECTION 9

Please indicate well location X.

ADDITIONAL INFORMATION

If more than one screen,
show locations of each on sketch.