

MISSISSIPPI DEPARTMENT OF NATURAL RESOURCES

Bureau of Land and Water Resources

Southport Mall

P.O. Box 10631

Jackson, Mississippi 39209

WATER WELL DRILLERS LOG

Date  
0 20 83

6-17 1983 date well completed  
 HICKS WELL CO. Dr. J. D. Hicks, firm name  
 Senatobia, MS 38668  
 Total county well located

LANDOWNER: Jack Talley  
 1/2 Chromcraft Corp.  
 Senatobia, Miss. 38668  
 (mailing address)

| description of formations encountered | from | to  |
|---------------------------------------|------|-----|
| Red Clay                              | 0    | 20  |
| Red Sand                              | 20   | 50  |
| Red Sand & Clay                       | 50   | 125 |
| White Sand                            | 125  | 230 |
| White Sand + Black Clay               | 230  | 245 |

WELL LOCATION:  
 sec. 1 T 6 N R 5 E  
 1 miles S of Tyno  
 (distance) (direction) (nearest town)

WELL PURPOSE: Home  
 (home, irrigation, municipal, industrial)

- WELL COMPLETION DATA:
- (1) diameter (inches) 4
  - (2) total depth (feet) 245
  - (3) static water level (feet) 150 below top of ground.
  - (4) casing PUC, 245 (material), (depth)  
 4" (size) if telescope see back.
  - (5) screen 10, 220' (length), (depth to top)  
 0.13, PUC (size), (material)
  - (6) pump 3/4, 10 (HP), (yield gpm)  
 220V (type power)
  - (7) electric log No (yes or no)
  - (organization running log)
  - (8) how well bottom plugged Cap

DRILLERS REMARKS:


DEPT. OF NATURAL RESOURCES  
 BUREAU OF LAND & WATER RESOURCES

JUN 27 1983

RECEIVED

If well telescopes please sketch and show depths.

GROUND LEVEL

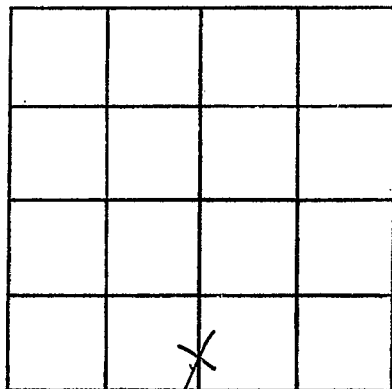

SECTION 11

Please indicate well location X.

ADDITIONAL INFORMATION

If more than one screen, show locations of each on sketch.