

MISSISSIPPI DEPARTMENT OF NATURAL RESOURCES

Bureau of Land and Water Resources

Southport Mall

P.O. Box 10631

Jackson, Mississippi 39209

WATER WELL DRILLERS LOG

<i>Tate</i>
<i>0 0</i>
<i>2020</i>

4-29 1983 Gullett Well Drilling Tate
 date well completed firm name county well located

LANDOWNER: Rex Kraner
Rt. 1 Box 125 EE
Senatobia, Ms 38668
 (mailing address)

description of formations encountered	depth	
	from	to
<u>Top soil</u>		
<u>and red clay</u>	<u>0</u>	<u>20</u>
<u>hard red clay</u>	<u>20</u>	<u>175</u>

WELL LOCATION:
 sec. 35 T. 6 N. R. 5 E. S. 5 W. 17 RD
 miles in of 7 (nearest town)

WELL PURPOSE: Home
 (home, irrigation, municipal, industrial)

- WELL COMPLETION DATA:
- (1) diameter (inches) 4"
 - (2) total depth (feet) 175'
 - (3) static water level (feet) 160 below above top of ground.
 - (4) casing 160 PVC, 175'
 (material) (depth)
4"
 (size) if telescope see back.
 - (5) screen 10'
 (length) (depth to top)
4", 160 PVC
 (size) (material)
 - (6) pump 1/2 10
 (HP) (yield gpm)
elec.
 (type power)
 - (7) electric log NO
 (yes or no)
- (organization running log)
- (8) how well bottom plugged Cap.

DRILLERS REMARKS:


DEPT. OF NATURAL RESOURCES
 BUREAU OF LAND & WATER RESOURCES

JUN 21 1983

RECEIVED

If well telescopes please sketch and show depths.

GROUND LEVEL

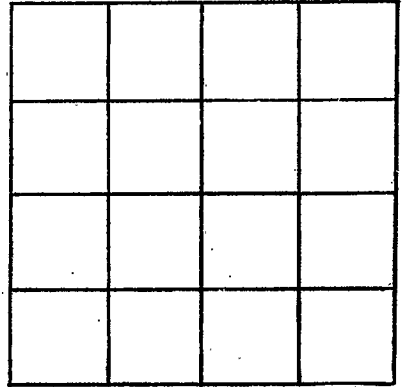

SECTION _____

Please indicate well location X.

ADDITIONAL INFORMATION

If more than one screen,
show locations of each on sketch.