

MISSISSIPPI DEPARTMENT OF NATURAL RESOURCES
 Bureau of Land and Water Resources
 Southport Mall
 P.O. Box 10631
 Jackson, Mississippi 39209
WATER WELL DRILLERS LOG

Date
02021

4-18 date well completed 1983 Gullett Well Drilling firm name Tate county well located

LANDOWNER: John Lemay
Tyro, Ms
 (mailing address)

description of formations encountered	from	to
<u>Top Sand and rd clay</u>	<u>0</u>	<u>20</u>
<u>Sand and clay</u>	<u>20</u>	<u>140</u>

WELL LOCATION:
 sec. 33 T. 6 S. R. 5
in miles in of Tyro
 (distance) (direction) (nearest town)

WELL PURPOSE: Home
 (home, irrigation, municipal, industrial)

WELL COMPLETION DATA:

- (1) diameter (inches) 4"
- (2) total depth (feet) 150'
- (3) static water level (feet) 125' below above top of ground.
- (4) casing 160 PVC, 150'
 (material) (depth)
4" if telescope see back.
 (size)
- (5) screen 10', 140'
 (length) (depth to top)
4", 160 PVC
 (size) (material)
- (6) pump 1/2, 10
 (HP) (yield gpm)
electric
 (type power)
- (7) electric log _____
 (yes or no)

 (organization running log)
- (8) how well bottom plugged Cap

DRILLERS REMARKS:


DEPT. OF NATURAL RESOURCES
 BUREAU OF LAND & WATER RESOURCES

JUN 21 1983

RECEIVED

If well telescopes please sketch and show depths.

GROUND LEVEL

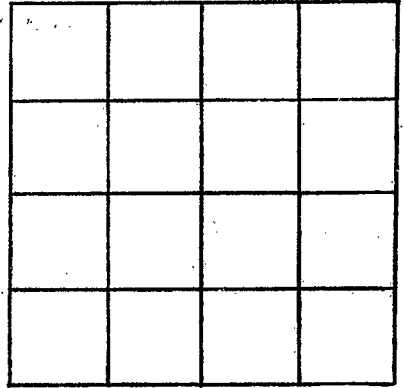

SECTION _____

Please indicate well location X.

ADDITIONAL INFORMATION

If more than one screen,
show locations of each on sketch.