

MISSISSIPPI DEPARTMENT OF NATURAL RESOURCES

Bureau of Land and Water Resources

Southport Mall

P.O. Box 10631

Jackson, Mississippi 39209

WATER WELL DRILLERS LOG

Date  
 0 2023

4/11 1984  
 date well completed

INDERS WELL CO.  
 firm name: 157

Tate  
 county well located

LANDOWNER: Murray Wooten  
Rt. 1  
Como, Mo. 38619  
 (mailing address)

description of formations encountered	from	to
Red Clay	0	10
Red sand	10	120
white sand	120	265

WELL LOCATION:  
 sec. 9 T 6 N R. 5 E  
1 miles SW of Tyng  
 (distance) (direction) (nearest town)

WELL PURPOSE: Home  
 (home, irrigation, municipal, industrial)

- WELL COMPLETION DATA:
- (1) diameter (inches) 4
  - (2) total depth (feet) 265
  - (3) static water level (feet) 170 <sup>below</sup> top of ground.
  - (4) casing PVC, 265  
 (material) (depth)  
4"  
 (size) If telescope see back.
  - (5) screen 10', 255  
 (length) (depth to top)  
010, PVC  
 (size) (material)
  - (6) pump 3/4 10  
 (HP) (yield gpm)  
220V  
 (type power)
  - (7) electric log No  
 (yes or no)

(organization running log)

(8) how well bottom plugged Cap

DRILLERS REMARKS:


DEPT. OF NATURAL RESOURCES  
 BUREAU OF LAND & WATER RESOURCES

MAY - 9 1984

RECEIVED

If well telescopes please sketch and show depths.

GROUND LEVEL

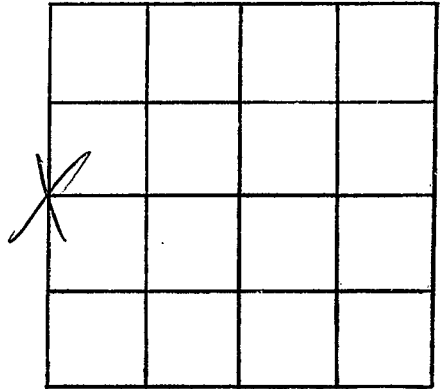

SECTION 9

Please indicate well location X.

ADDITIONAL INFORMATION

If more than one screen, show locations of each on sketch.