

MISSISSIPPI DEPARTMENT OF NATURAL RESOURCES

Bureau of Land and Water Resources

Southport Mall

P.O. Box 10631

Jackson, Mississippi 39209

WATER WELL DRILLERS LOG

Date  
 O 2004

8-10 19 84

HICKS WELL CO.  
 PL. 1, BOX 157  
 Senatobia, MS 38668

Tate  
 county well located

LANDOWNER:	description of formations encountered	from	to
Mt. Vernon Church Pt. 1	Red Clay	0	10
Senatobia, Ms. 38668 (mailing address)	Red Sand	10	20
WELL LOCATION: sec. 7 T 6 N R 5 E	Black Clay	20	50
4 miles W of Tate (distance) (direction) (nearest town)	White Clay + Sands	50	80
WELL PURPOSE: Church (home, irrigation, municipal, industrial)	White Sand	80	160
WELL COMPLETION DATA:			
(1) diameter (inches) 4			
(2) total depth (feet) 160			
(3) static water level (feet) 140 below above top of ground.			
(4) casing PVC 160 (material) (depth) 4" if telescope see back. (size)			
(5) screen 10' 150' (length) (depth to top) .010 PVC (size) (material)			
(6) pump 1/2 10 (HP) (yield gpm) 220V (type power)			
(7) electric log Yes (yes or no) (organization running log)			
(8) how well bottom plugged Cap			
DRILLERS REMARKS:			


DEPT. OF NATURAL RESOURCES  
 BUREAU OF LAND & WATER RESOURCES

SEP 24 1984

RECEIVED

If well telescopes please sketch and show depths.

GROUND LEVEL

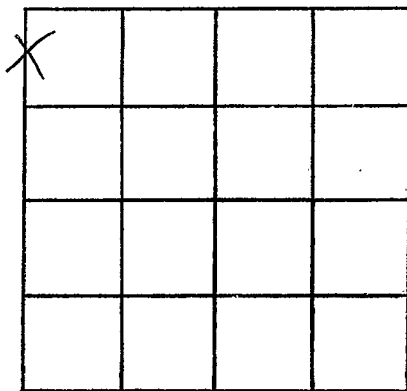

SECTION 7

Please indicate well location X.

ADDITIONAL INFORMATION

If more than one screen, show locations of each on sketch.