

MISSISSIPPI DEPARTMENT OF NATURAL RESOURCES

Bureau of Land and Water Resources

Southport Mall

P.O. Box 10631

Jackson, Mississippi 39209

WATER WELL DRILLERS LOG

HICKS WELL COMPANY

0 2025
Tate
7-29-85

7-29-19 85
date well completed

RT 1 BOX 157

firm name
SENATOBIA MISS

Tate
county well located

LANDOWNER: Ollie Watson

description of formations encountered

from to

Rt # 1

Senatobia ms 38868
(mailing address)

Red clay

0 20

Red Sand

20 30

WELL LOCATION:

sec. 16 T 6 N R 5 E
(S) (W)
2 miles S of Tyro
(distance) (direction) (nearest town)

White Sand & Clay

30 180

White Sand

180 245

WELL PURPOSE: Home
(home, irrigation, municipal, industrial)

WELL COMPLETION DATA:

- (1) diameter (inches) 4"
- (2) total depth (feet) 245'
- (3) static water level (feet) 200 ^{below} above top of ground.
- (4) casing PVC 230'
(material) (depth)
4" If telescope see back.
(size)
- (5) screen 15' 230'
(length) (depth to top)
.013 PVC
(size) (material)
- (6) pump 3/4 10
(HP) (yield gpm)
220 V
(type power)
- (7) electric log NO
(yes or no)

(organization running log)


(8) how well bottom plugged Cap

DRILLERS REMARKS:

RECEIVED
OCT 17 1985

If well telescopes please sketch and show depths.

GROUND LEVEL

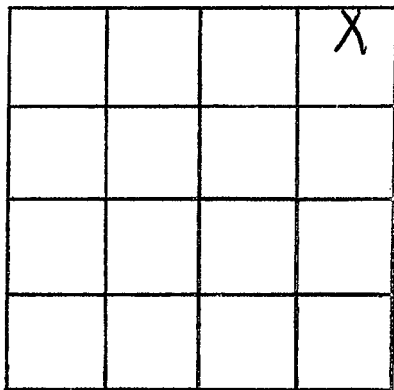

SECTION 16

Please indicate well location X.

ADDITIONAL INFORMATION

If more than one screen,
show locations of each on sketch.