

MISSISSIPPI DEPARTMENT OF NATURAL RESOURCES

Bureau of Land and Water Resources

Southport Mall

P.O. Box 10631

Jackson, Mississippi 39209

WATER WELL DRILLERS LOG

HICKS WELL COMPANY

Tate
~~Joe~~
 1-23-85

1-23 1985 RT. 1 BOX 157 TATE
 date well completed firm name county well located
 SENATORIA MISS

LANDOWNER: Joe Samuel
 1978 Aloy
 Memphis TN 38114
 (mailing address)

description of formations encountered	from	to
Red clay	0	10
Red Sand	10	30
White Sand	30	245

WELL LOCATION:
 sec. 11 T. 6 N. R. 5 E
 (S) SE (W)
 1 miles East of Tyro
 (distance) (direction) (nearest town)

WELL PURPOSE: Home
 (home, irrigation, municipal, industrial)

WELL COMPLETION DATA:

(1) diameter (inches) 4"

(2) total depth (feet) 245'

(3) static water level (feet) 160' below top of ground.

(4) casing PVC, 235' (depth)
 4" (size) if telescope see back.

(5) screen 10' (length), 235' (depth to top)
 .010 (size), PVC (material)

(6) pump 3/4 (HP), 10 (yield gpm)
 220 V (type power)

(7) electric log NO (yes or no)
 (organization running log)

(8) how well bottom plugged cap


RECEIVED
 JUL 1 - 1985

DRILLERS REMARKS:

Department of Natural Resources
 Bureau of Land & Water Resources

If well telescopes please sketch and show depths.

GROUND LEVEL

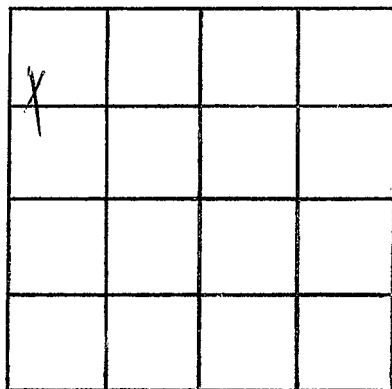

SECTION 11

Please indicate well location X.

ADDITIONAL INFORMATION

If more than one screen, show locations of each on sketch.