

MISSISSIPPI DEPARTMENT OF NATURAL RESOURCES

Bureau of Land and Water Resources

Southport Mall

P.O. Box 10631

Jackson, Mississippi 39209

WATER WELL DRILLERS LOG

TATE
Φ 2007

HICKS WELL COMPANY

Tate

8-2-1985  
date well completed

RT. 1 BOX 157  
firm name

county well located

SENAROBIA, MISS.

LANDOWNER: Cecil Howell

description of formations encountered

from to

Rt # 1

Senarobia MS 38868  
(mailing address)

Red clay

0 20

Red Sand

20 50

white Sand

50 140

WELL LOCATION:

sec. 6 T. 6 N. R. 5 E  
S W  
3 miles W of Tyro  
(distance) (direction) (nearest town)


WELL PURPOSE: Home  
(home, irrigation, municipal, industrial)

WELL COMPLETION DATA:

- (1) diameter (inches) 4"
- (2) total depth (feet) 140'
- (3) static water level (feet) 80 below above top of ground.
- (4) casing PVC, 130'  
(material) (depth)  
4" if telescope see back.  
(size)
- (5) screen 10', 130'  
(length) (depth to top)  
.03, PVC  
(size) (material)
- (6) pump 3/4 10  
(HP) (yield gpm)  
220 V  
(type power)
- (7) electric log No  
(yes or no)

(organization running log)

(8) how well bottom plugged Cap

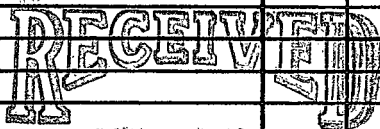


NOV - 1 1985

DRILLERS REMARKS:

Department of Natural Resources  
Bureau of Land & Water Resources

If well telescopes please sketch and show depths.

GROUND LEVEL

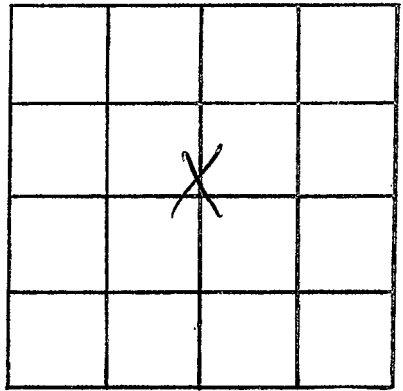

SECTION 6

Please indicate well location X.

ADDITIONAL INFORMATION

If more than one screen, show locations of each on sketch.