

MISSISSIPPI DEPARTMENT OF NATURAL RESOURCES

Bureau of Land and Water Resources

Southport Mall

P.O. Box 10631

Jackson, Mississippi 39209

WATER WELL DRILLERS LOG

HICKS WELL COMPANY

DATE
 12/20/85

date well completed 9-20 1985

RT. 1 - BOX 157

county well located State

SENATODIA, MISS.

LANDOWNER: Willie Image

description of formations encountered

from

to

Rt # 1

Red clay

0 30

Senatobia MS 3866P
 (mailing address)

Red sand

30 60

WELL LOCATION:

sec. 3 T 6 N R 5 E
 S W
 1 miles N of Tyro
 (distance) (direction) (nearest town)

White clay & white sand

60 180

White sand

180 245

WELL PURPOSE:

(home, irrigation, municipal, industrial) None


WELL COMPLETION DATA:

- (1) diameter (inches) 4"
- (2) total depth (feet) 245'
- (3) static water level (feet) 160' ^{below} above top of ground.
- (4) casing PVC, 235'
 (material) (depth)
4"
 (size) if telescope see back.
- (5) screen 10', 235'
 (length) (depth to top)
013, PVC
 (size) (material)
- (6) pump 3/4, 10
 (HP) (yield gpm)
220V
 (type power)
- (7) electric log NO
 (yes or no)

(organization running log)

(8) how well bottom plugged Cop


DRILLERS REMARKS:

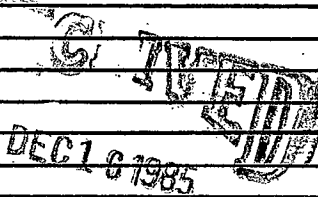

Department of Natural Resources
 Bureau of Land and Water Resources

If well telescopes please sketch and show depths.

GROUND LEVEL

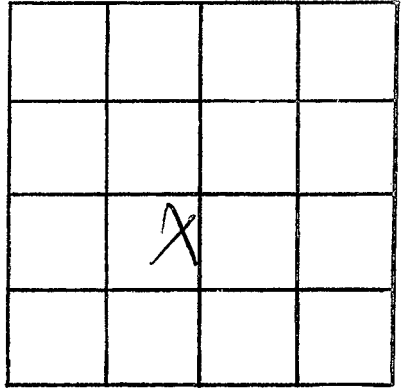

SECTION 3

Please indicate well location X.

ADDITIONAL INFORMATION

If more than one screen, show locations of each on sketch.