

MISSISSIPPI DEPARTMENT OF NATURAL RESOURCES

Bureau of Land and Water Resources

Southport Mall

P.O. Box 10631

Jackson, Mississippi 39209

WATER WELL DRILLERS LOG

TATE  
Dolan

HICKS WELL COMPANY

11-20 1985  
date well completed

Rt. 1 - fifth name/

Jate  
county well located

LANDOWNER: David Roreran

SENATORIA, MISS.

description of formations encountered

from to

5731 Maple Tree Drive

Red clay

0 10

Morglia, TN  
(mailing address)

Red sand

10 30

WELL LOCATION:

sec. 14 T. 6 N. R. 5 E  
S W  
3 miles SE of Tyro  
(distance) (direction) (nearest town)

White sand

30 180

WELL PURPOSE: Home  
(home, irrigation, municipal, industrial)

Black clay

180 245

WELL COMPLETION DATA:


White sand

245 280

- (1) diameter (inches) 4"
- (2) total depth (feet) 280'
- (3) static water level (feet) 140' <sup>below</sup> above top of ground.
- (4) casing PVC, 240' (material) (depth)  
4" (size) if telescope see back.
- (5) screen 20' (length), 260' (depth to top)  
.013 (size), PVC (material)
- (6) pump 1hp (HP), 18 (yield gpm)  
220W (type power)
- (7) electric log No (yes or no)

(organization running log)

(8) how well bottom plugged Cap

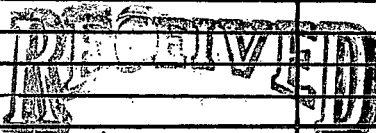


DEC 16 1985

DRILLERS REMARKS:

If well telescopes please sketch and show depths.

GROUND LEVEL

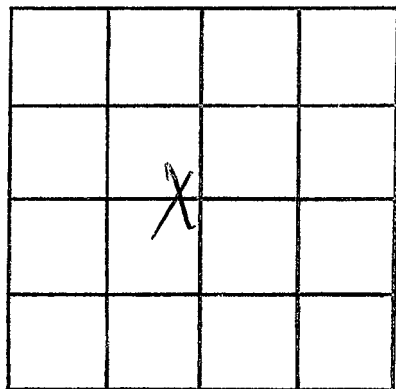

SECTION 14

Please indicate well location X.

ADDITIONAL INFORMATION

If more than one screen,  
show locations of each on sketch.