

MISSISSIPPI DEPARTMENT OF NATURAL RESOURCES
 Bureau of Land and Water Resources

P.O. Box 10631
 Jackson, Mississippi 39209
WATER WELL DRILLERS LOG

COUNTY WELL LOCATED
TATE

WELL NUMBER **Q2030** CODED

DATE WELL COMPLETED
8-1-86

PERMIT NUMBER

NAME OF DRILLING FIRM
Hicks Well Co

Senatobia, Ms

NAME & MAILING ADDRESS OF LANDOWNER
Pat Howell
RT. 1
Senatobia, Ms.

WELL LOCATION: SEC 1 TOWNSHIP 6^N RANGE 5^E (W)

DISTANCE 4 MILES DIRECTION SW of NEAREST TOWN LOOKALHAMA

OTHER LANDMARK

WELL PURPOSE: Home Irrigation, Municipal, Industrial, Fish Pond, etc.

PUMP DATA

PUMP TYPE (Circle One):
 Submersible, Turbine, Jet Flowing Well,
 Other (Describe) _____

POWER TYPE (Circle One):
 Electric, Tractor, Diesel, Gasoline, Butane,
 Other (Describe) _____

Pump Capacity (GPM)	No. of Stages	Setting Depth	
<u>10</u>	<u>10</u>	<u>80</u>	FT.

PUMP TEST

Well yielded 10 GPM with a drawdown of _____ ft. after _____ hours of pumping

WELL DATA

Well Depth <u>130</u>	Casing Diameter (In.) <u>4"</u>	Casing Length (Ft.) <u>120</u>
Type of Casing <u>PVC</u>	Hole Depth <u>130</u>	Depth to Static Water Level <u>60</u>

TYPE OF COMPLETION: (Circle One or More):
 Gravel Packed, Underreamed, Telescoped,
 Natural Development, Open Hole, Other
 (Describe) _____

Top of Lap Pipe or Reduction in Casing

FEET IF TELESCOPED OR MORE THAN ONE SCREEN: USE BACK PAGE

LOG DATA

TYPE OF LOG RUN (Circle One):
 No Log Run, Electric, Gamma Ray, Density, Sonic, Neutron,
 Other (Describe) _____

Name of Organization Running Log

SCREEN DATA


Diameter - Inches	Length - Feet	Slot Size - Inches
Screen Type	Depth to Bottom - Feet	

GEOLOGIC DATA (Office Use Only)

Surface Elev.	Geologic Unit	Unit Thickness	Depth to Top
Subs. SWL	Date	Analysis	Aquifer Test

Driller's Remarks

DESCRIPTION OF FORMATIONS ENCOUNTERED	FROM	TO	FORMATIONS (Continued)	FROM	TO
<u>R.C.</u>	<u>0</u>	<u>20</u>			
<u>RS-C.</u>	<u>20</u>	<u>100</u>			
<u>W.S.</u>	<u>100</u>	<u>130</u>			

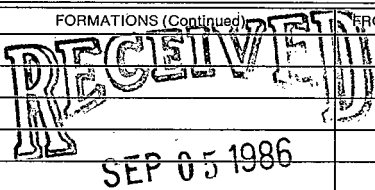


Department of Natural Resources
 Bureau of Land & Water Resources

IF MORE SPACE IS NEEDED, USE BACK

If well telescopes please
sketch and show depths.

GROUND LEVEL

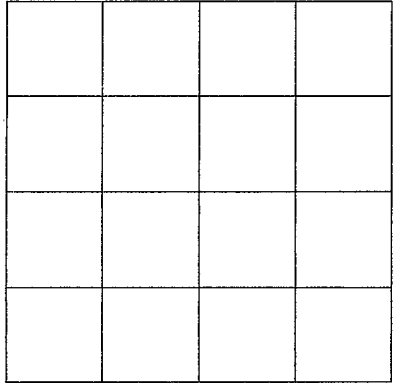

SECTION _____

Please indicate well location X.

ADDITIONAL INFORMATION

If more than one screen,
show location of each on sketch.