

MISSISSIPPI DEPARTMENT OF NATURAL RESOURCES

Bureau of Land and Water Resources

Southport Mall

P.O. Box 10631


Jackson, Mississippi 39209

WATER WELL DRILLERS LOG

<u>TATE</u>
<u>DO</u>
<u>2023</u>

date well completed 1-23 1986 HICKS WELL COMPANY Jate
 RT. 1 RAY county well located

LANDOWNER: <u>Willie Newman</u>	description of formations encountered		from	to
<u>762 Navasota</u>	<u>Red clay</u>		<u>0</u>	<u>20</u>
<u>Memphis, TN</u> (mailing address)	<u>Red sand</u>		<u>20</u>	<u>50</u>
WELL LOCATION: sec. <u>3</u> T. <u>6</u> N. R. <u>5</u> E. (distance) <u>1</u> miles <u>N</u> of <u>Juno</u> (direction) (nearest town)	<u>white sand</u>		<u>50</u>	<u>245</u>
WELL PURPOSE: (home, irrigation, municipal, industrial) <u>None</u>				
WELL COMPLETION DATA: (1) diameter (inches) <u>4"</u> (2) total depth (feet) <u>245'</u> (3) static water level (feet) <u>180'</u> below top of ground. (4) casing <u>PVC</u> (<u>235'</u>) (material) (depth) <u>4"</u> (size) if telescope see back. (5) screen <u>10'</u> (<u>135'</u>) (length) (depth to top) <u>013</u> (<u>PVC</u>) (size) (material) (6) pump <u>2hp</u> (<u>18</u>) (HP) (yield gpm) <u>220V</u> (type power) (7) electric log <u>NO</u> (yes or no) (organization running log) (8) how well bottom plugged <u>Cap</u>				

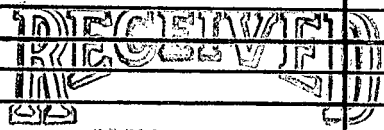


Department of Natural Resources
 Bureau of Land & Water Resources

DRILLERS REMARKS:

If well telescopes please sketch and show depths.

GROUND LEVEL

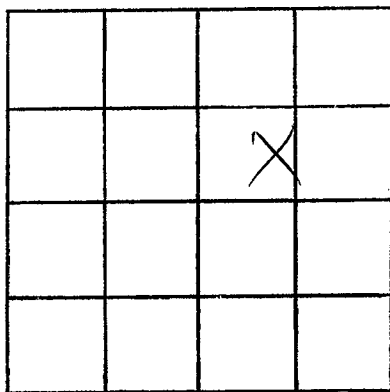

SECTION 3

Please indicate well location X.

ADDITIONAL INFORMATION

If more than one screen, show locations of each on sketch.