

MISSISSIPPI DEPARTMENT OF ENVIRONMENTAL QUALITY

Office of Land and Water Resources

COUNTY WELL LOCATED TATE	
WELL NUMBER Φ	CODED
DATE WELL COMPLETED 2050	
5-1-95	

PERMIT NUMBER HICKS WELL CO.
NAME OF DRILLING FIRM RT. 1 BOX 157
SENATOBIA, MS 38668

P. O. Box 10631
Jackson, MS 39289-0631
WATER WELL DRILLERS LOG

NAME & MAILING ADDRESS OF LANDOWNER Gene Wright			
RT-1			
Senatobia, MS 38668			
WELL LOCATION:	SEC	TOWNSHIP	RANGE
	5	6	5
		N	E
DISTANCE	DIRECTION	NEAREST TOWN	
7 Miles	E	of Lockhart	
OTHER LANDMARK Tyro Acid			
WELL PURPOSE (Circle one): Irrigation, Municipal, Industrial, Fish Pond, etc. Irrigation			

PUMP DATA			
PUMP TYPE (Circle One): Submersible Turbine, Jet, Flowing Well, Other (Describe) _____			
POWER TYPE (Circle One): Electric, Tractor, Diesel, Gasoline, Butane, Other (Describe) _____ H/P 1/2			
Pump Capacity (GPM)	No. of Stages	Setting Depth	
10	9	140 FT.	
PUMP TEST			
Well yielded _____ GPM with a drawdown of _____ ft. after _____ hours of pumping			

WELL DATA		
Well Depth 180'	Casing Diameter (In.) 4"	Casing Length (Ft.) 170'
Type of Casing PVC	Hole Depth 180	Depth to Static Water Level 120'

LOG DATA	
TYPE OF LOG RUN (Circle One): No Log Run, Electric, Gamma Ray, Density, Sonic, Neutron, Other (Describe) _____	
Name of Organization Running Log	

TYPE OF COMPLETION: (Circle One or More): Gravel Packed , Underreamed, Telescoped, Natural Development, Open Hole, Other			
WELL GROUTED TO A DEPTH OF 10 FEET Type Grout (circle one): Cement , Bentonite, or Mix			

GEOLOGIC DATA (Office Use Only)			
Surface Elev.	Geologic Unit	Unit Thickness	Depth to Top
Subs. SWL	Date	Analysis	Aquifer Test


SCREEN DATA		
Diameter - Inches 4"	Length - Feet 10'	Slot Size - Inches 013
Screen Type PVC	Depth to Bottom - Feet 101	

Driller's Remarks	
Top of Lap Pipe or Reduction in Casing	
FEET	IF TELESCOPED OR MORE THAN ONE SCREEN: USE BACK PAGE

DESCRIPTION OF FORMATIONS ENCOUNTERED	FROM	TO	FORMATIONS (Continued)	FROM	TO
Red Sand	0	40	RECEIVED		
Sand & clay	40	120			
White Sand	120	180			
			JUL 24 1995		
			Dept. of Environmental Quality Office of Land & Water Resources		
			IF MORE SPACE IS NEEDED, USE BACK		

If well telescopes please sketch and show depths.

GROUND LEVEL

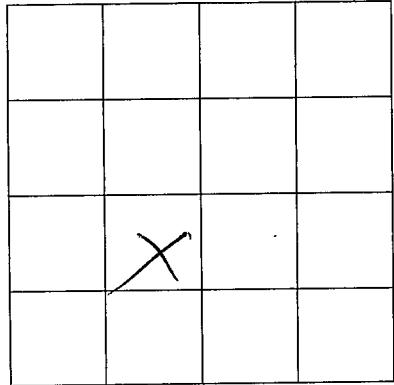

SECTION 5

Please indicate well location X.

ADDITIONAL INFORMATION

If more than one screen,
show location of each on sketch.