

MISSISSIPPI DEPARTMENT OF ENVIRONMENTAL QUALITY

Office of Land and Water Resources

P. O. Box 10631  
Jackson, MS 39289-0631  
WATER WELL DRILLERS LOG

COUNTY WELL LOCATED TALe	
WELL NUMBER ① 2052	CODED
DATE WELL COMPLETED 7-20-95	

PERMIT NUMBER <b>HICKS WELL CO.</b>
NAME OF DRILLING FIRM P.O. BOX 157 SENATOBIA, MS 38668

NAME & MAILING ADDRESS OF LANDOWNER Sterling D. Williams		
7420 BENJES TOWN RD		
Millington TENN		
WELL LOCATION:	SEC	TOWNSHIP
	10	6 <sup>N</sup> 5 <sup>E</sup> W
DISTANCE	DIRECTION	NEAREST TOWN
10 Miles	NE	Como
OTHER LANDMARK		
WELL PURPOSE: Home, Irrigation, Municipal, Industrial, Fish Pond, etc.		

PUMP DATA		
PUMP TYPE (Circle One): <u>Submersible</u> Turbine, Jet, Flowing Well, Other (Describe) _____		
POWER TYPE (Circle One): <u>Electric</u> , Tractor, Diesel, Gasoline, Butane, Other (Describe) _____ H/P <u>1</u>		
Pump Capacity (GPM)	No. of Stages	Setting Depth
10	12	240 FT.
PUMP TEST		
Well yielded _____ GPM with		
a drawdown of _____ ft.		
after _____ hours of pumping		

WELL DATA		
Well Depth 260'	Casing Diameter (In.) 4"	Casing Length (Ft.) 245'
Type of Casing PVC	Hole Depth 260'	Depth to Static Water Level 200'
TYPE OF COMPLETION: (Circle One or More): <u>Gravel Packed</u> , Underreamed, Telescoped, Natural Development, Open Hole, Other		
WELL GROUTED TO A DEPTH OF <u>10</u> FEET Type Grout (circle one): <u>Cement</u> , Bentonite, or Mix		

LOG DATA	
TYPE OF LOG RUN (Circle One): No Log Run, Electric, Gamma Ray, Density, Sonic, Neutron, Other (Describe) _____	
Name of Organization Running Log	

SCREEN DATA		
Diameter - Inches 4"	Length - Feet 15'	Slot Size - Inches .013
Screen Type PVC	Depth to Bottom - Feet 15'	

GEOLOGIC DATA (Office Use Only)			
Surface Elev.	Geologic Unit	Unit Thickness	Depth to Top
Subs. SWL	Date	Analysis	Aquifer Test

DESCRIPTION OF FORMATIONS ENCOUNTERED	FROM	TO	FORMATIONS (Continued)	FROM	TO
Red sand	0	40			
Sand & clay	40	180			
Clay	180	220			
White sand	220	260			

IF TELESKOPED OR MORE THAN ONE SCREEN, USE BACK PAGE

FEB 05 1996

Dept. of Environmental Quality  
Office of Land & Water Resources


IF MORE SPACE IS NEEDED, USE BACK

If well telescopes please  
sketch and show depths.

---

GROUND LEVEL

---

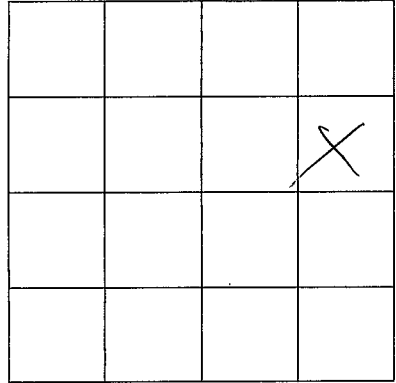

SECTION 10

Please indicate well location X.

---

ADDITIONAL INFORMATION

---

If more than one screen,  
show location of each on sketch.

---